


Section 34 Township 21 Range 16W

Well No. 3 Phinney

Company _____

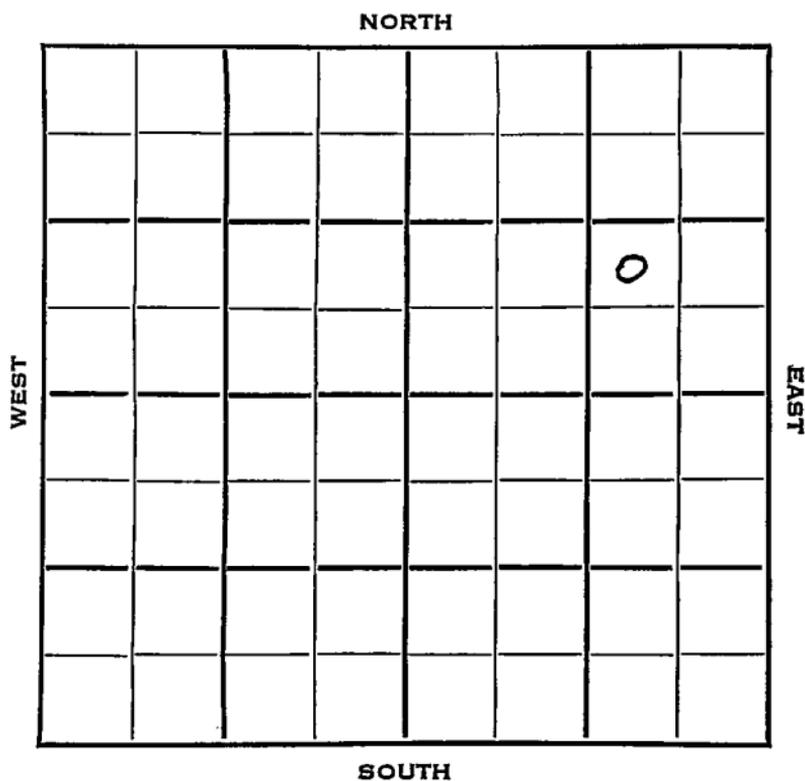

Pawnee

KANSAS

SEC.	TWP.	R.
34	21	16W


WELL NO. #3 Phinney FARM

COMPANY Musgrove Pet.

CONTRACTOR

Larned Pool

_____ Ft. from N. Line
 990 _____ Ft. from S. Line
 990 _____ Ft. from E. Line
 _____ Ft. from W. Line

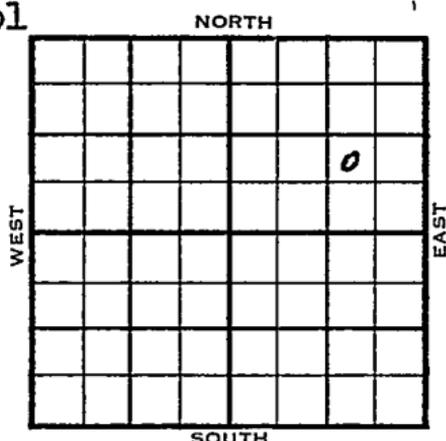

NW SE NE

1954	ELEVATION	REPORT
	1986' RB, 1983' IS	

1/27 Spud 1-13-54
 8" @ 1023'
 Heeb 3384', Tor 3403', Br. Lime 3488'
 Lans 3498', Cong 3793', Viola 3849',
 Simp 3854' Arb 3864'
 DST 3866'-69' opn 1 hr, rec 2100' gas,
 120' oily mud, 1020' oil, 1150#
 TD 3869'
 5" @ 3866'

2/3 WOCT.
 C.O. 3869'
 S/ 12 boph 4 hrs.

2/17 Spud 1-13-54
 Oil Well
 TD 3869'
 8" @ 1023'
 Heeb 3384', Tor 3403', Br lime 3488',
 Lans 3498', Cong 3793', Viola 3849',
 Simp. 3854', Arb. 3864'
 DST 3866'-69', opn 1 hr., rec. 2100'
 gas, 120' oily mud, 1020' oil, 1150#
 TD 3869'
 5" @ 3866
 CO to 3869
 S/12 boph 4 hrs.
 Comp. 559 bopd

COMPLETED

