

Section 34 Township 21 Range 16 WWell No. # 2 WeimanCompany Musgrove Pet.

NORTH

			0				

WEST

EAST

SOUTH

Pawnee

KANSAS ✓

Sec. 34 Twp. 21 R. 16W

Well No. #2 Weiman Farm

Musgrove Pet. Company

Musgrove Contractor

Larned Pool


990 Ft. from N. Line

 Ft. from S. Line

330 Ft. from E. Line

 Ft. from W. Line

SE NE NW

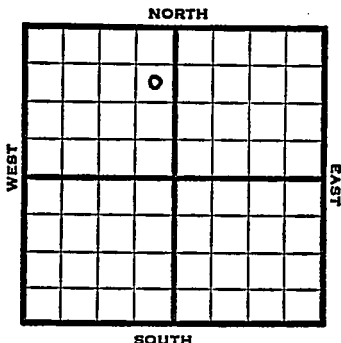

1953 Elev. 1993' REPORT

5/20 Spud 5-16-53
8" @ 927'
Anhy 970'
Drlg 1010'

*3 4 5 2
3 4 5 3
3 4 5 3*

5/28 Drlg 3450'

*3 4 5 2
3 4 5 3
3 4 5 4*

6/3 Heeb 3392; Br li 3490, Lans 3499,
B KC 3722, Cong 3774, Arb 3852
RTD 3854
5" @ 3853, CO 3854

6/10 FU 2500' fluid
FU 2500' oil. WOP

6/24 Spud 5-16-53 Oil well TD 3854
8" @ 927 Anhy 970 Heeb 3392
Br lime 3490 Lans 3499 B KC 3722
Cong. 3774 Arb. 3852 TD 3854
5" @ 3853 CO to 3854 FU 2500'
oil.
Comp. 3000 BOPD

COMPLETED

County Pawnee State KansasSec. 34 (Blk.) 21 (Sur.) 16W Map No.Operator Musgrove Pet.Well No. 2 Farm WeimanElev. Location SE NE NW

990 Ft. From N Line NW330 Ft. From E Line Quarter1st. Report MAY 20 1953

Completion

Remarks

Musgrove - Contr.Spudding Date 5-16-53Drlg. Data Larned Pool8" @ 927 Anhy 970 drlg. 1010

J. G. McGEHEE