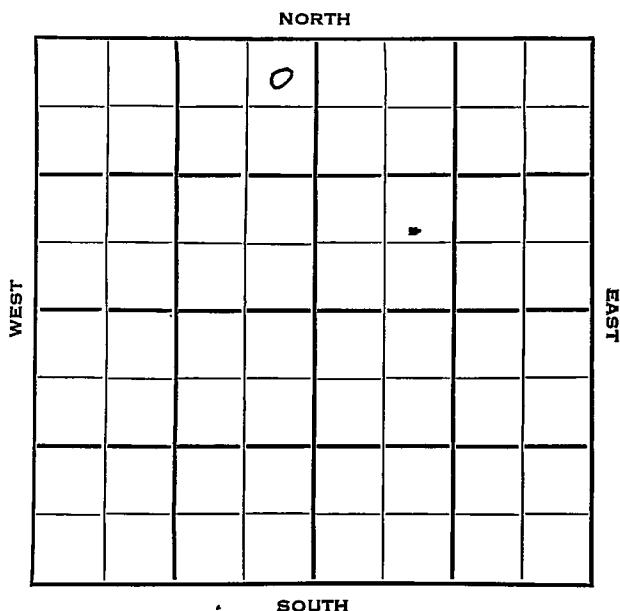


Section 34 Township 21 Range 16WWell No. #3 WeimenCompany Musgrove Petr.

Pawnee

KANSAS

Sec. 34 Twp. 21 R. 16W ✓Well No. #3 Weimen Farm

Musgrove Pet.

Company

Larned Pool

Contractor

330

Ft. from N. Line


Ft. from S. Line

330

Ft. from E. Line

Ft. from W. Line

NE NE NW

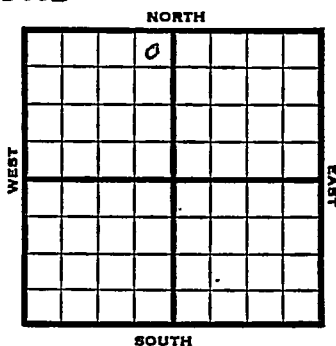

1953

Elev. 1991' REPORT

9/2

Location

9/9

8" @ 980' w/450 sks
Dr1g 1355'

9/16

Heeb 3376, Tor 3402, Br li 3484, Lans
3495, Simp 3797, Arb 3852
RTD 3854

9/23

5" @ 3853'
DD 3866' TD S/3½ BOPH 5 hrs. 500 A
S/15 BOPH 2912' O.B. POP

9/30

NR

10/14

"

10/21

Spud 9-3-53 Oil well TD 3866
8" @ 980 Heeb 3376 Tor 3402
Br. line 3484 Lans 3495 Simp. 3797
Arb. 3852 TD 3854 5" @ 3853
DD 3866 S/3½ BOPH 5 hr. 500 A
S/15 BOPH P/19½ BOPH
Comp. 3000 BOPD

COMPLETED

3552
3447
335

3552
1991
1861

County Pawnee State Kansas
 Sec. 34 (Blk.) 21 (Sur.) 165 Map No.
 Operator Musgrove Pet.
 Well No. 3 Farm Weimer
 Elev. _____ Location NE NE NW

			0				

330 Ft. From N Line NW

330 Ft. From E Line Quarter

1st. Report SEP 2 1953

Completion _____

Remarks _____

Spudding Date _____

Drlg. Data _____

Larned Pool

Location

County Pawnee State KansasSec. 34 (Blk.) 21 (Sur.) 16W Map No.Operator Musgrove Pet.Well No. 3 Farm WeimanElev. 1991 Location NE NE NW

		0			

330 Ft. From N Line NW330 Ft. From E Line Quarter1st. ReportCompletion OCT 21 1953Remarks Larned PoolSpudding Date 9-3-53Drlg. Data Oil well TD 38668"@ 980 Heeb. 3376 Tor. 3402Br. lime 3484 Lans. 3495 Simp. 3797Arb. 3852 TD 3854 5" @ 3853DD 3866 S/ $3\frac{1}{2}$ boph 5 hr. 500 AS/ 15 boph P/ $19\frac{1}{2}$ bophComp. 3000 bopd