

Section 34 Township 21 Range 16W

Well No. #1 Weiman

Company Musgrove Pet.

NORTH

WEST									

EAST

SOUTH


SEC.	TWP.	R.
34	21	16W ✓

WELL NO. #4 Weiman FARM

COMPANY Musgrove Pet.

CONTRACTOR Musgrove

Larned Pool  
~~660~~ 990 Ft. from N. Line  
 \_\_\_\_\_ Ft. from S. Line  
 \_\_\_\_\_ Ft. from E. Line  
~~330~~ 660 Ft. from W. Line

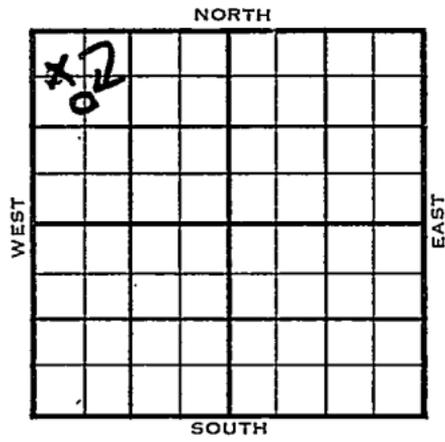

<sup>S</sup>  
 C ~~H~~ L NW NW

1953	ELEVATION	REPORT
	1992'	
9/23		Spud 9-16-53 8" @ 982' Drlg 3090'
9/30		Heeb 3383' Tor 3418' Br li 3492' Lans 3502' B KC 3716' Cong 3806' Simp. 3830' Arb. 3843' RTD 3845' 5" @ 3844'
10/14		WOCT
10/21		CO 3845' FU 1600' oil 1½ hrs. DD 3855' S/18½ BOPH 3 hrs. 2900' O.B. DD 3863' TD S/19½ BOPH 5 hrs. POP
10/28		P/ 23½ boph
11/4		Spud 9-16-53 Oil Well TD 3863' 8" @ 982' Heeb 3383, Tor 3418', Br. Lime 3492, Lans 3502, B KC 3716, Cong 3806, Simp 3830, Arb 3843 TD 3845' 5" @ 3844' CO to 3845 FU 1600' oil 1½ hr. DD 3855

1953

Information brought forward.

11/4 S/  $18\frac{1}{2}$  boph 3 hr.  
DD 3863  
S/  $19\frac{1}{2}$  boph 5 hr.  
P/  $23\frac{1}{2}$  boph  
Comp 3000 bopd.

**COMPLETED**



Kansas

Map No. \_\_\_\_\_ Sec. 34 Twp. 21 R. 16W

Well No. 4 Weiman

Musgrove Pet. Company

**CORRECTION**

Contractor

C S L NW NW

990 Ft. from N. Line

\_\_\_\_\_ Ft. from S. Line

\_\_\_\_\_ Ft. from E. Line

660 Ft. from W. Line

SECTION PLAT

o			

Pawnee County

Location \_\_\_\_\_

Rig up \_\_\_\_\_

Drilling and Remarks:

Reported

C W L NW NW

RECORD

Cased \_\_\_\_\_ in., \_\_\_\_\_ ft.

Sand \_\_\_\_\_

Gas \_\_\_\_\_

Oil \_\_\_\_\_

Total Depth \_\_\_\_\_

PRODUCTION

1st 24 hrs. Nat. \_\_\_\_\_

1st 24 hrs. after shot \_\_\_\_\_

Gas \_\_\_\_\_ Cu. Ft.

Dry Hole \_\_\_\_\_

Abandoned \_\_\_\_\_

Date


SEP 30 1953

19

J. G. McGEHEE

Scout

County Pawnee State Kansas  
 Sec. 34 (Blk. Twp.) 21 (Sur. Rge.) 16W Map No.  
 Operator Musgrove Pet.  
 Well No. 4 Farm Weiman  
 Elev. 1992 Location C S L NW NW

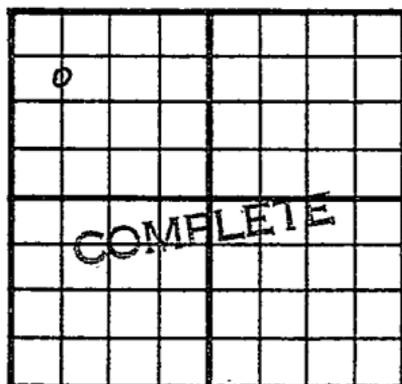

990ft. From N Line NW

660ft. From W Line Quarter

Ist. Report

Completion NOV 4 1952

Remarks Larned Pool

Musgrove - Contr.

Spudding Date 9-16-53

Drlg. Data Oil well TD 3863

8" @ 982 Heeb. 3383 Tor. 3418

Br. lime 3492 Lans. 3502 B KC 3716

Cong. 3806 Simp. 3830 Arb. 3843

TD 3845 5" @ 3844 CO to 3845

FU 1600' oil  $1\frac{1}{2}$  hr. DD 3855 S/  $18\frac{1}{2}$ boph 3 hr. DD 3863 S/  $19\frac{1}{2}$  boph 5 hr.P/  $23\frac{1}{2}$  boph Comp. 3000 bopd

J. G. McGEHEE