


Section 34 Township 21 Range 16W

Well No. #1 Wieman

Company Musgrove Petroleum

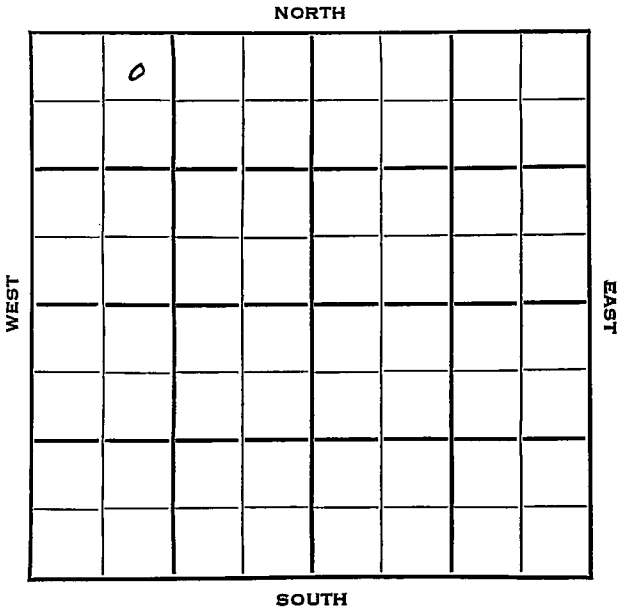

Sec. 34 Twp. 21 R. 16 W

Well No. # 1 Wieman Farm

Musgrove Pet Company

Musgrove Contractor

Larned Pool


330 Ft. from N. Line

_____ Ft. from S. Line

_____ Ft. from E. Line

990 Ft. from W. Line

NE NW NW

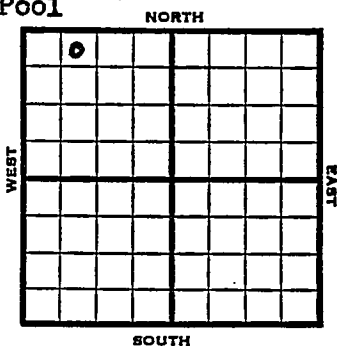

1953 Elev. 1991' REPORT

2/11 Spud 2-7-53
8" @ 1012 WOC

2/19 Anhy 1000'
Pipe stuck @ 3380

2/26 Heeb 3379½ Br li 3480, Lans
3490, B KC 3711, Cong 3771,
ReW Simp 3798, Arb 3843,
RTD 3846
5" @ 3844½ w/150

3/12 CO 3846
S/8 BOPH 3 hrs.
20 BOPH 2150' O.B.

3/19 NR

3/26 TD 3863 S/21 BOPH

4/1 Spud 2-7-53 Oil well TD 3863
8" @ 1012 Anhy 1000 Heeb 3379
Br lime 3480 Lans 3490 B KC 3711
Cong. 3771 ReSimp 3798 Arb. 3843
TD 3846 5" @ 3844½ CO to 3846
S/8 BOPH 3 hr. 20 BOPH DD 3863
S/21 BOPH 4 hr.
Comp. 3000 BOPD

Handwritten calculation:
3440
- 330

3410

Handwritten calculation:
3843
- 1991

1852

COMPLETED

County Pawnee State Kansas

Sec. 34 (Blk. Twp.) 21 (Sur. Rge.) 16W Map No.

Operator Musgrove Pat.

Well No. 1 Farm Wieman

Elev. Location NE NE NW

0					

330 Ft. From N Line NW

990 Ft. From W Line Quarter

1st. Report FEB 11 1953

Completion

Remarks

Musgrove - Contr.

Spudding Date 2-7-53

Drig. Data Larned Pool

8" @ 1012 WOC

County Pawnee State Kansas

Sec. 34 (Blk. Twp.) 21 (Sur. Rge.) 16W Map No.

Operator Musgrove Pet.

Well No. 1 Farm Wieman

Elev. 1991 Location NE NW NW

0					
COMPLETE					

330 Ft. From N Line NW

990 Ft. From W Line Quarter

1st. Report

Completion APR 1 1953

Remarks Lanned Pool

Musgrove - Contr.

Spudding Date 2-7-53

Drlg. Data Oil well TD 3863

8" @ 1012 Anhy 1000 Heeb. 3379

Br. lime 3480 Lans. 3490 B KC 3711

Cong. 3771 ReSimp. 3798 Arb. 3843

TD 3846 5" @ 3844 $\frac{1}{2}$ CO to 3846

S/ 8 boph 3 hr. 20 boph DD 3863

S/ 21 boph 4 hr. Comp. 3000 bopd