


KANSAS Finney

Section 34 Township 21 Range 34W

Well No. 1 Jones Aelite

Company Shallow Water Ref.

Nunn Pool

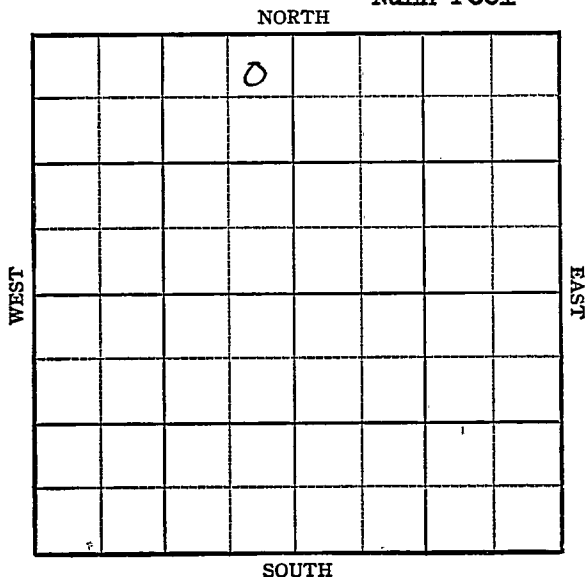

KANSAS Finney ✓

Sec. 34 Twp. 21 R. 34W

Well No. 1-Jones Aeilt's Farm

Shallow Water Ref. Company

Nunn Pool

660'

330

Ft. from N. Line

Ft. from S. Line

660'


330

Ft. from E. Line

Ft. from W. Line

~~NE NW~~

C NE NW

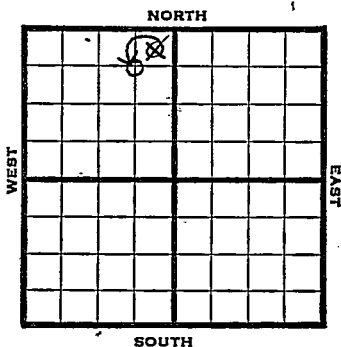

1948

Elev. 2960' REPORT

9/1

Surface Hole

9/8

10" @ 262'

Drlg. 3705'

9/14

Drlg 4576'

9/21

TD 4731'

5" @ 4626'

9/29

Miss 4622'

Pump 108 bbls oil

1000 acid

10/6

Miss 4622'

5" @ 4626'

6000 acid

Pump 988 Pot.

Gr. 31°

TD 4731'

COMPLETED

Finney County Kansas StateMap No. _____ Sec. 34 Twp. 21 R. 34WWell No. 1 JonesShallow Water Ref. Company _____**FIRST REPORT**

Contractor _____

NE NW

SECTION PLAT

			o			

330 Ft. from N. Line Ft. from S. Line330 Ft. from E. Line Ft. from W. LineNunn Pool

Remarks:

surface hole

Date
SEP 1 1948

Scout

S. J. LEWIS

Finney County Kansas StateMap No. _____ Sec. 34 Twp. 21 R. 34WWell No. 1 Aeilts

Shallow Water Ref. _____ Company

CORRECTION

Contractor

C NE NW

SECTION PLAT

660 Ft. from N. Line

_____ Ft. from S. Line

660 Ft. from E. Line

_____ Ft. from W. Line

Nunn Pool

Remarks:

Reported NE NW as #1 Jones

Date
SEP 8 1948

Scout S. J. LEWIS

Map No. _____ Sec. 34 Twp. 21 R. 34^WWell No. 1 Aeilte

Shallow Water Ref. _____ Company _____

COMPLETE

Contractor _____

C NE NW

E1.2960
SECTION PLAT660 Ft. from N. Line

_____ Ft. from S. Line

660 Ft. from E. Line

_____ Ft. from W. Line

	0		

Finney County

Location _____

Rig up _____

Drilling and Remarks:

*Miss 4622**5" @ 4626**6000 acid**Prod 988 bbl**312 bbl*

RECORD

Cased _____ in., _____ ft.

Sand *66'* _____

Gas _____

Oil *✓* _____Total Depth 4731

PRODUCTION

1st 24 hrs. Nat. _____

1st 24 hrs. after shot _____

Gas _____ Cu. Ft.

Dry Hole _____

Abandoned _____

Date

OCT 6 1948 19 S. J. LEWIS Scout