


Section 34 Township 21 Range 34-W

Well No. #3 Aeiltz (Aeiltz)

Company Shallow Water Refinery

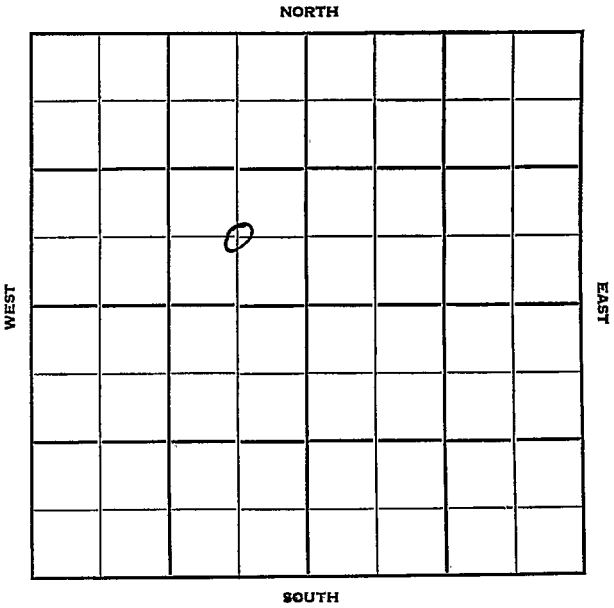

Finney

KANSAS

Sec. 34 Twp. 21 R. 34W

Well No. #3 Aeilts Farm

Shallow Water Refinery Company

Pabco Drlg. - Contr. Contractor

Nunn Pool


Ft. from N. Line

660' Ft. from S. Line

660' Ft. from E. Line

Ft. from W. Line


C SE NW

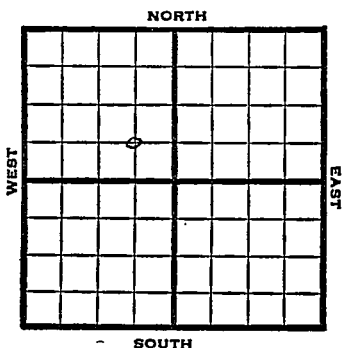

1950. Elev 2958' REPORT

11/8 Spud 10-31-50
12" @ 245'
WOC
12/20 12" @ 245
Marmaton 4260 Miss 4625
lime 4628
5" @ 4718
TD 4727
S/ $\frac{1}{4}$ boph 7000 A
S/22 boph
Dec. to 14 boph
Comp 448 bopd
Completed

COMPLETED

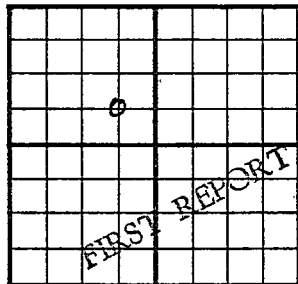County Finney State KansasSec. 34 (Blk.) 21 (Sur.) 34W Map No.Operator Shallow Water RefineryWell No. 3 Farm AeiltsElev. 2958 Location C SE NW660 Ft. From S Line NW660 Ft. From E Line Quarter1st. Report NOV 8 1950


Completion

Remarks

Pabco Drlg. - Contr.Spudding Date 10-31-50Drlg. Data Nunn Pool12" @ 245 WOC

J. E. TYRA

County Finney State Kansas
 Sec. 34 (Blk.) 21 (Sur.) 34W Map No.
 Operator Shallow Water Refinery
 Well No. 3 Farm Aeilts
 Elev. 2958 Location C SE NW

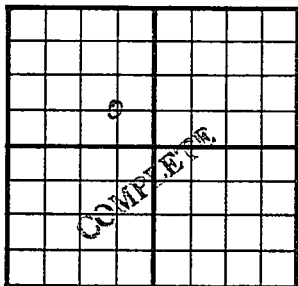

660 Ft. From S Line NW
660 Ft. From E Line Quarter
 Ist. Report
 Completion DEC 20 1950
 Remarks Nunn Pool
Pabco Drlg. - Contr.
 Spudding Date 10-31-50

Drlg. Data Oil well TD 4727
12" C 245 Marmaton 4260 Miss. 4625
Line 4628 5" C 4718 TD 4727 S/ $\frac{1}{4}$ boph
7000 A S/ 22 boph Dec. to 14 boph
Comp. 448 bopd

J. E. TYRA