


KANSAS

Finney

Section 34 Township 21 Range 34-WWell No. #6 Gobleman "A"Company Shallow Water Ref.*Do not have a 1st report ticket*

NORTH

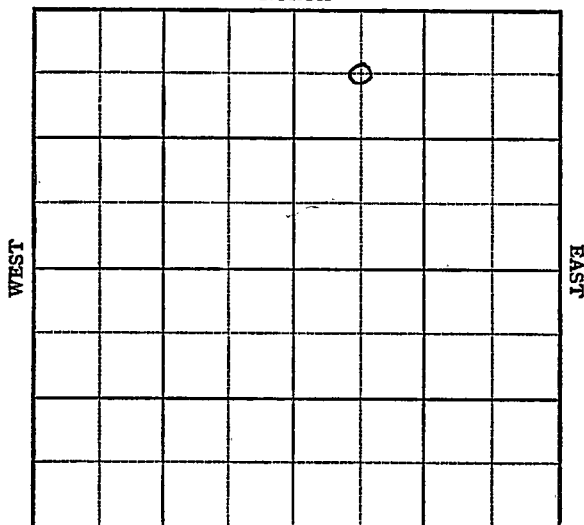

SOUTH

O. W. P. B.

KANSAS

Finney

34W ✓
~~24W~~

Sec. 34 Twp. 21 R. ~~24~~

Well No. #6 Gobleman "A" Farm

Shallow Water Ref. Company

Shallow Water


660 Ft. from N. Line

 Ft. from S. Line

 Ft. from E. Line

660 Ft. from W. Line

C NW NE

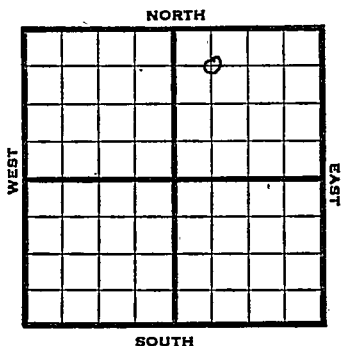

1947

Elev. 2954' REPORT

9/3

Drilling 3000'

9/10

Lansing 3848'
Mississippi 4556'
TD 4663'
5" @ 4661'
RUST

9/17

" "

9/24

Miss. 4656'
5" @ 4661'
10000 Acid
Pump 447 Pot
32.0 Gr.
TD 4694'

COMPLETED
O. W. P. B.

1950

9/27

Lans 3848 Miss 4656
OTD 4694
5" @ 4661
PB
96/4286-98 in Marmaton
3500 A
Test 11 boph plus sw

OVER

1950

10/11 Oil Well TD 4298'
Lans. 3848' Miss 4656'
OTD 4694 5" @ 4661
PB 96/4286-98 in Marmaton
3500 A. Comp. 40 bopd

COMPLETED

Map No. 0 Sec. 34 Twp. 21 R. 34W

Well No. 6 Gobleman "A"

Shallow Water Ref. Company

CORRECTION

Contractor

C NW NE


SECTION PLAT

660 Ft. from N. Line

 Ft. from S. Line

 Ft. from E. Line

660 Ft. from W. Line

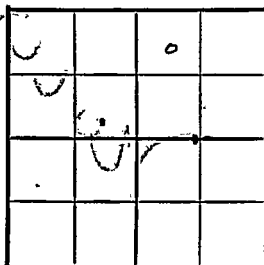

Finney County

Location

Rig up

Drilling and Remarks:

Reported

34-21-24W

RECORD

Cased in., ft.

Sand

Gas

Oil

Total Depth

PRODUCTION

1st 24 hrs. Nat.

1st 24 hrs. after shot

Gas Cu. Ft.

Dry Hole

Abandoned

Date

SEP 3 1947 1947

S. J. LEWIS

Scout

Map No. 0 Sec. 34 Twp. 21 R. 34W

Well No. 6 Gobleman "A"

Shallow Water Ref. Company

COMPLETE

Contractor

C NW NE

E1,2954
SECTION PLAT

660 Ft. from N. Line

 Ft. from S. Line

 Ft. from E. Line

660 Ft. from W. Line

		o	
		.	

Finney County

Location

Rig up

Drilling and Remarks:

Mis 4656

5" @ 4661

10000 acd

Ping 447 Pot

22 2/3

RECORD

Cased in. 3 1/2 ft.

Sand

Gas

Oil

Total Depth 4684

PRODUCTION

1st 24 hrs. Nat.

1st 24 hrs. after shot

Gas Cu. Ft.

Dry Hole

Abandoned

Date

SEP 24 1947

19

S. J. LEWIS

Scout

County Finney State Kansas
 Sec. 34 (Blk.) 21 (Sur.) 34W Map No. 21
 Operator Shallow Water
 Well No. 6 Farm Gobleman
 Elev. 2954 Location C NW NE



660 Ft. From E Line NE
660 Ft. From W Line Quarter

1st. Report SEP 27 1950

Completion

Remarks SWPB
O. W. P. B.

Spudding Date

Drlg. Data Hugoton Pool


Lans. 3348 Miss. 4656 OTD 4694

5" @ 4661 PB 96/ 4286-98 in Marmaton

3500 A Test 11 boph plus sw

J. E. TYRA

County Finney State Kansas
 Sec. 34 (Blk.) 21 (Sur.) 34W Map No.
 Operator Shallow Water
 Well No. 6 Farm Gobleman
 Elev. 2954 Location C NW NE

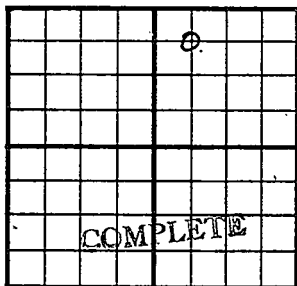

660 Ft. From N Line NE
660 Ft. From W Line Quarter

Ist. Report

Completion OCT 11 1950

Remarks Hugoton Pool

OWPB

Spudding Date

Drlg. Data Oil well TD 4298

Lans. 3848 Miss. 4656 OTD 4694

5" @ 4661 PB 96/ 4286-98 in Marmaton

3500 A Comp. 40 bopd

J. E. TYRA