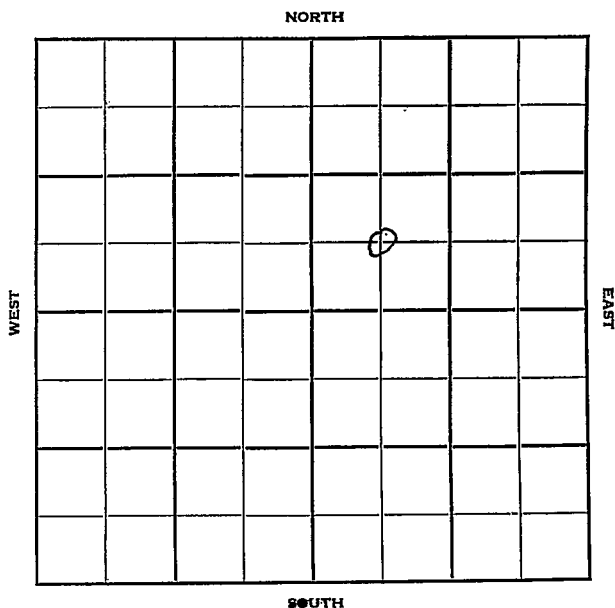


Section 34 Township 21 Range 34WWell No. #8 Gobleman "A"Company Shallow Wtr Ref.

Finney

KANSAS

Sec. 34 Twp. 21 R. 34W

Well No. #8 Gobleman "A" Farm

Shallow Water Ref. Company

Nunn Pool Contractor


 Ft. from N. Line

660' Ft. from S. Line

 Ft. from E. Line

660' Ft. from W. Line

C SW NE

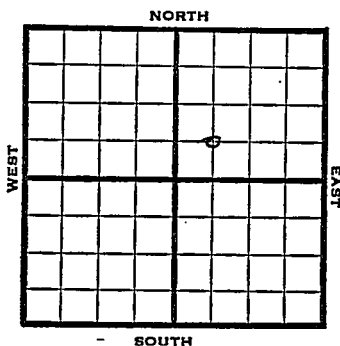

1950

Elev 2952' REPORT

12/6

Location

1951

1/24

Spud 12-7-50

8" @ 274

Marmaton 4299

Miss 4632

TD 4731

5 1/2" @ 4683

10 qt/4712-16

1500 A

SP 4660

48/4632-40 500 A SP 4333

48/4299-4307

1000 A SP 4360


2000 A

D&A TD 4731

ABANDONED

J. E. TYRA

County Finney State Kansas
 Sec. 34 (Blk. 21 (Sur. 34W Map No.
 Operator Shallow Water Ref.
 Well No. 8 Farm Gobleman "A"
 Elev. 2952 Location C SW NE

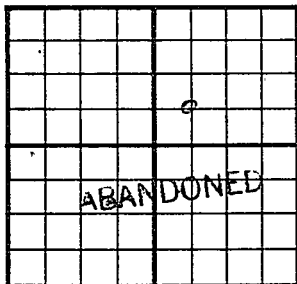

660 Ft. From S Line NE
 660 Ft. From W Line Quarter

1st. Report

Completion JAN 24 1951

Remarks Nunn Pool

Spudding Date 12-7-50

Drlg. Data D & A TD 4731

8" @ 274 Marmaton 4299 Miss. 4632

TD 4731 5½" @ 4683 10 qt/ 4712-16 1500 A

SP 4660 48/ 4632-40 500 A SP 4333

48/ 4299-4307 1000 A SP 4360 2000 A

D & A

J. E. TYRA