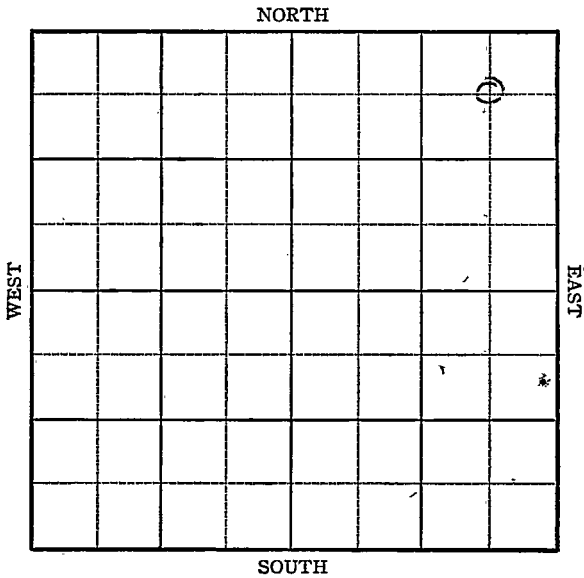


KANSAS

Finney

FORM 51 5M PETROL

Section 34 Township 21 Range 34WWell No. 3 Golbeman "A" (Gobleman)Company Atlantic

Sec. 34 Twp. 21 R. 34

Well No. #3 Gobleman "A" Farm

Atlantic Company


Nunn

660 Ft. from N. Line

Ft. from S. Line

660 Ft. from E. Line

Ft. from W. Line

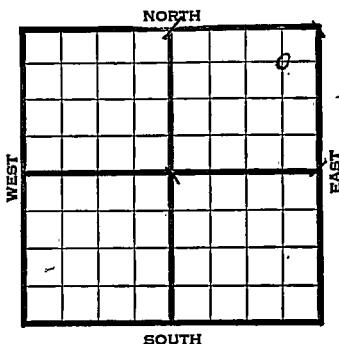

C NE NE Elev. 2944

1945

REPORT

7/3 Location

7/11 Surface hole

7/19 10" @ 236

Drlg. 2540

7/26 Krider 2560

Drlg. 3100

8/1 Drlg. 4206

8/8 Lans 3850

Patterson Sd 4623

Miss. 4633

TD 4657' SO

Run 5"

8/8 SLM 4657 equal 51 TD

Patterson 4617

Miss. 4627

5" @ 4632

8/22 TD 4178

750' oil 14 hrs.

8/29 TD 4736 1200' oil 24 hrs.

9/5 2000 acid.

Pump $3\frac{1}{2}$ oil per hr.

9/12 " " " "

9/19 " " " "

9/26 " " " "

10/3 " " " "

10/10 Miss. 4627

5" @ 4632

1000 acid.

TD 4738'

Pump 603 oil plus 4% Wtr. Pot.

Grav. 31.0

COMPLETED

KANSAS

Pool Name NunnMap No. no map Sec. 34 Twp. 21 R. 34WWell No. 3 Gobleman "A"Atlantic Company

FIRST REPORT

Contractor

C NE NE

SECTION PLAT

			0

660 Ft. from N. Line Ft. from S. Line660 Ft. from E. Line Ft. from W. Line

Finney County

Location XRig up Drilling and Remarks:

RECORD

Cased in., ft.Sand Gas Oil Total Depth

PRODUCTION

1st 24 hrs. Nat. 1st 24 hrs. after shot Gas Cu. Ft.Dry Hole Abandoned

Date

JUL 3 1945 19S. J. LEWIS

Scout

KANSAS

Pool Name NunnMap No. 120 m Sec. 34 Twp. 21 R. 34WWell No. 3 Gobleman "A"Atlantic

Company

COMPLETED

Contractor

E12944

C NE NE

SECTION PLAT

			0

660 Ft. from N. Line Ft. from S. Line660 Ft. from E. Line Ft. from W. LineFinney CountyLocation Rig up

Drilling and Remarks:

Miss 46275" @ 463210000 acidPump 603 oil + 4 7/8 WRT31° E

RECORD

Cased in., ft.Sand Gas Oil Total Depth 4738'

PRODUCTION

1st 24 hrs. Nat. 1st 24 hrs. after shot Gas Cu. Ft.Dry Hole Abandoned

Date

OCT 10 194519S. J. LEWIS

Scout