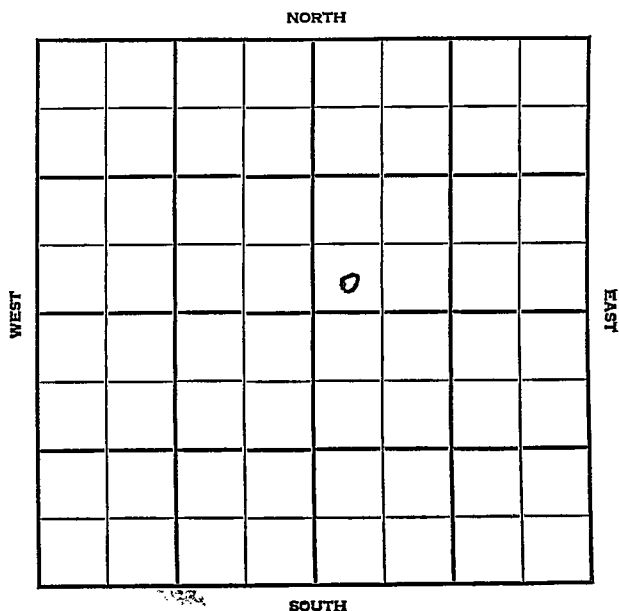


Section 35 Township 21 Range 12WWell No. 1 SittnerCompany Mid-States

Stafford

KANSAS

SEC.	TWP.	R.
35	21	12 W

WELL NO.

1 Sittner

FARM

COMPANY

Mid-States

CONTRACTOR

Gabbert-Jones

Max Pool


_____ Ft. from N. Line

330 _____ Ft. from S. Line

_____ Ft. from E. Line

330 _____ Ft. from W. Line

SW SW NE

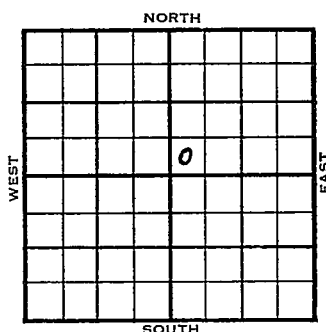

1955

ELEVATION

1823'

REPORT

2/9

Location

4/20

Spud 2-13-55 - Oil Well

TD 3605'

8" @ 260'

Heeb. 3091', Tor. 3109', Br lime 3222'

Lans. 3241'

DST 3354-85', opn 1 hr., rec. 30' mud, 0#

DST 3432-45', opn 1 hr., rec. 40' mud, salty mud, 0#

Viola 3507', Simp. 3537', Arb. 3598'

DST 3600-05', opn 1 hr., rec. 500'

gassy oil, 180' HOCM, 780#

TD 3605'

5" @ 3600'

Schl Tops: Br. lime 3222', Lans

3241', Viola 3502', Simp. 3546', Arb.

3598'

CO to 3605'

S/5 boph 2-hrs.


P/96 bo 21 hrs.

P/44 bo 24 hrs.

P/36 bo 24 hrs.

Comp. 78 bopd

COMPLETED

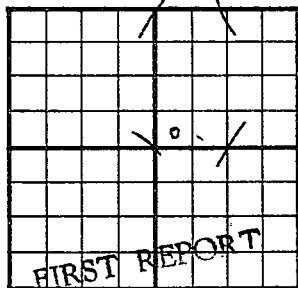County Stafford State KansasSec. 35 (Blk.) 21 (Sur.) 12W Map No.Operator Mid-StatesWell No. 1 Farm SittnerElev. _____ Location SW 1/4330 Ft. From S Line NE330 Ft. From W Line Quarter1st. Report FEB 9 1955

Completion _____

Remarks _____


Gabbert-Jones - Contr.

Spudding Date _____

Drlg. Data Max PoolLocation

FABEN GILSTRAD

County Stafford State Kansas
 Sec. 35 (Blk. 21) (Sur. 12W) (Twp.) Map No.
 Operator Mid-States
 Well No. 1 Farm Sittner
 Elev. 1823 Location SW SW NE

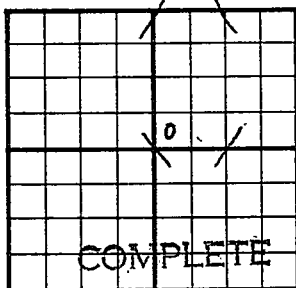

330 Ft. From S Line NE
330 Ft. From W Line Quarter

1st. Report

Completion Apr 20 1955

Remarks Max Pool

Gabbert-Jones - Contr.

Spudding Date 2-13-55

Drlg. Data Oil well TD 3605

8" @ 260 Heeb. 3091 Tor. 3109

Br. lime 3222 Lans. 3241 DST 3354-85

open 1 hr. Rec. 30' mud 0# DST 3432-45

open 1 hr. Rec. 40' salty mud 0#

Viola 3507 Simp. 3537 Arb. 3598

DST 3600-05 open 1 hr. Rec. 500' gaspy

oil 180' Hocm 780# TD 3605. 5" @ 3600

SCHLUMBERGER TOPS:

Br. lime 3222 Lans. 3241 Viola 3502

Simp. 3546 Arb. 3598 CO to 3605

S/ 5 boph 2 hr. P/ 96 bo 21 hr.

P/ 44 bo 24 hr. P/ 36 bo 24 hr.

Comp. 78 bopd

FABEN GILSTRAP