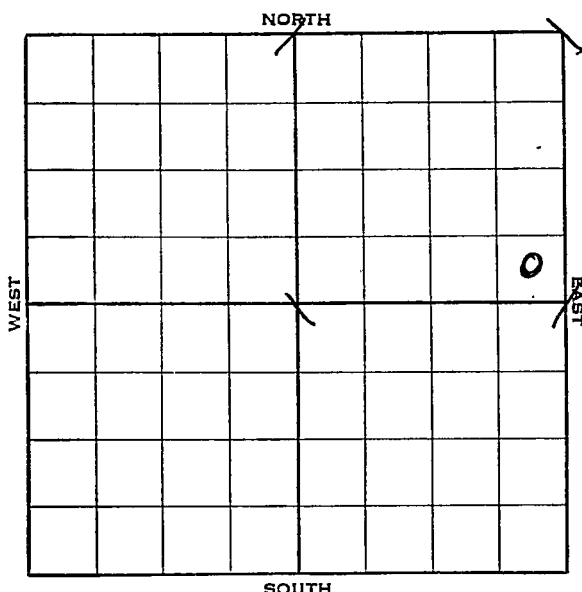



Stafford

KANSAS

Section 35 Township 21 Range 12-WWell No. 1 SittnerCompany H. L. Rowley et al

Sec. 35 Twp. 21 R. 12-WWell No. #1 Sittner FarmH. L. Rowley et al Company Ft. from N. Line330 Ft. from S. Line330 Ft. from E. Line Ft. from W. Line

Elev. 1820

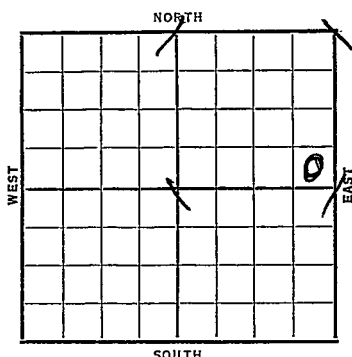

Date

REPORT

1938

7/27 B.R.R.

8/5 10" - 263'.. Anhy 590'.

Drlg. 1925'..

8/12 Topeka 2830'.. Dlg.. 3035'.

8/19 Lans. 3235'.. S.S.O.. 3375-76'

& 3384-85'.. Cong. 3515'.

Simp. 3520'.. Arb. 3565'.

T. D. 3575'.. S. O. 7" - 3565'.

8/26 Drilled plug. 2700' oil 8 hrs.

8/31 7" - 3565'.

Arb. 3565'.

T. D. 3575'.

1000 acid.

Pump 263 bbls. 4 hrs. & 206 bbls

4 hours.

Potential 1230 bbls.

Gravity 42.5/66

COMPLETED

Stafford KANSAS

Map No. 46 Sec. 35 Twp. 21 R. 12WWell No. 1 SittnerH L Rowley ETal


Company

OT 00 Contractor

FIRST REPORT

FORM-OUT
SECTION PLAT

SE NE

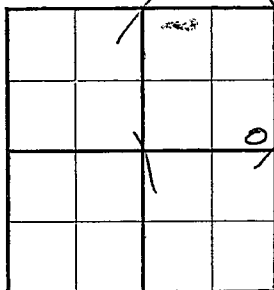11 Ft. from N. Line330 Ft. from S. Line330 Ft. from E. Line Ft. from W. Line**Special**Location Rig up

Drilling and Remarks:

BRR

RECORD

Cased in., ft.Sand Gas Oil Total Depth

PRODUCTION

1st 24 hrs. Nat. 1st 24 hrs. after shot Gas Cu. Ft.Dry Hole Abandoned

Date

JUL 27 1938 19H. D. Hatfield Scout

Stafford **KANSAS**Map No. 46 Sec. 35 Twp. 21 R. 12WWell No. 1 SittnerH. L. Rowley etal Company

Contractor

COMPLETED

SE NE

 Ft. from N. Line330 Ft. from S. Line330 Ft. from E. Line Ft. from W. Line**SECTION PLAT**

			o

Location Rig up

Drilling and Remarks:

*1000 acid**P-26 3/4 x 206/4**pot 12 1/2
gravel 42.5/64***RECORD**Cased 7 in., 3565 ft.Sand A-6 3565Gas Oil Total Depth 3575**PRODUCTION**1st 24 hrs. Nat. 1st 24 hrs. after shot Gas Cu. Ft.Dry Hole Abandoned

Date

AUG 31 1938 19 H. D. Hatfield Scout