


Section 35 Township 21 Range 12W

Well No. 1 Teichmann

Company Lindas Oil

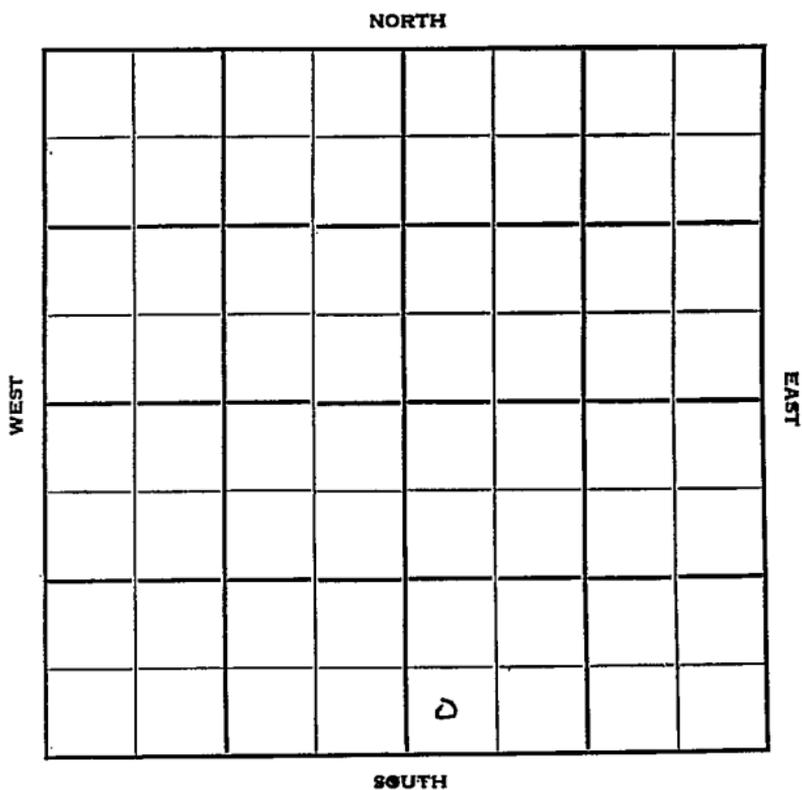

Sec. 35 Twp. 21 R. 12W

Well No. #1 Teichmann Farm

Lindas Oil Company

Lindas - Contr. Contractor

Max Pool


_____ Ft. from N. Line

330' Ft. from S. Line

_____ Ft. from E. Line

330' Ft. from W. Line

SW SW SE

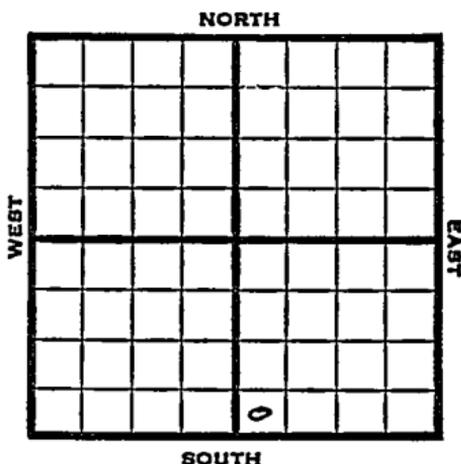

1951 Elv. 1828' REPORT

7/17 Spud 7-12-51
8" @ 168

Anhy 595
Drlg. 2180'

7/25 Spud 7-12-51
D&A TD 3650
8" @ 168

Anhy 595
Heeb. 3103
Br Lime 3236

Lans. 3249
Cong. 3531

Viola 3537
Arb. 3643

TD 3650
D&A

ABANDONED


County Stafford State Kansas

Sec. 35 (Blk. 21 (Sur. 12W (Twp. Map No. Rge.)

Operator Lindas Oil

Well No. 1 Farm Teichmann

Elev. _____ Location SW SW SE

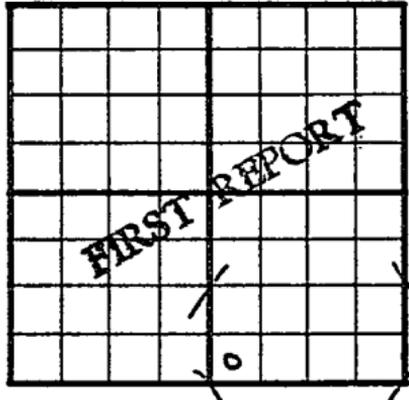

330 Ft. From S Line SE

330 Ft. From W Line Quarter

1st. Report JUL 18 1951

Completion _____

Remarks _____

Lindas - Contr.

Spudding Date 7-12-51

Drig. Data _____ Max Pool

8" @ 168 Anhy 595 drlg. 2180

J. E. TYRA


County Stafford State Kansas

Sec. 35 (Blk. 21) (Sur. 12W) (Twp.) (Rge.) Map No.

Operator Lindas Oil

Well No. 1 Farm Teichmann

Elev. 1828 Location SW SW SE

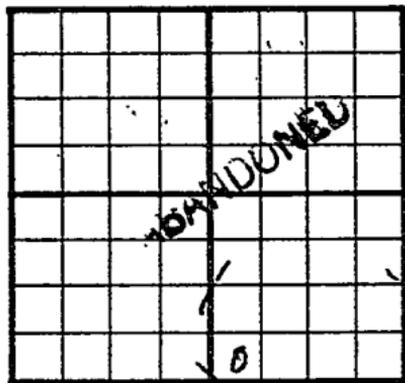

330 Ft. From S Line SE

330 Ft. From W Line Quarter

1st. Report

Completion JUL 25 1951

Remarks Max Pool

Lindas - Contr.

Spudding Date 7-12-51

Drig. Data D & A TD 3650

8" @ 168 Anhy 595 Heeb. 3103

Br. lime 3236 Lans. 3249 Cong. 3531

Viola 3537 Arb. 3648 TD 3650

D & A

J. E. TYRA