


Section 35 Township 21 Range 12-W

Well No. 1 Teichmann

Company Trigg Drlg. & Tom Allen

NORTH Miscellaneous

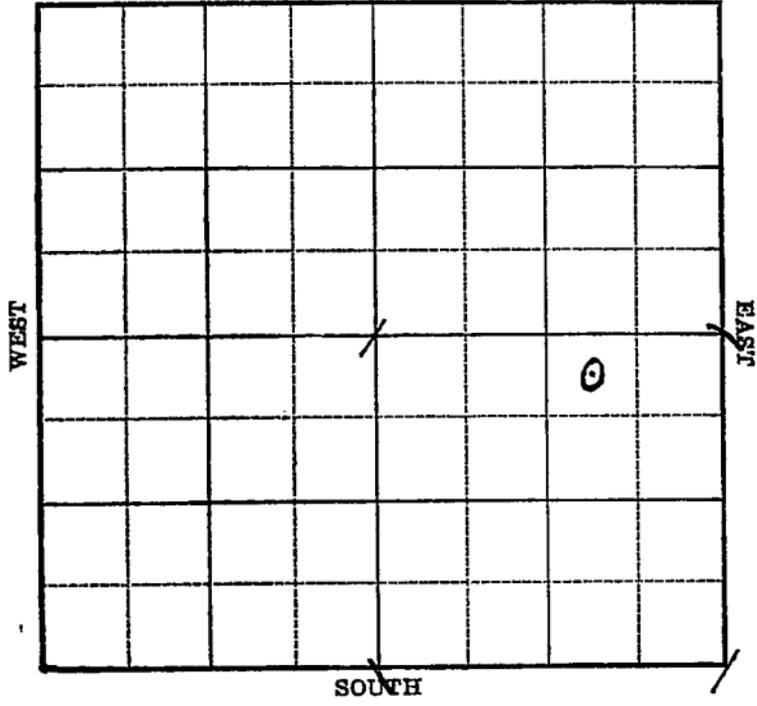

Sec. 35 Twp. 21 R. 12-W

Well No. #1 Teichmann Farm

Trigg Drlg. & Tom Allen Company

(Miscellaneous)


330 Ft. from N. Line

_____ Ft. from S. Line

990 Ft. from E. Line

_____ Ft. from W. Line

Elev. 1822

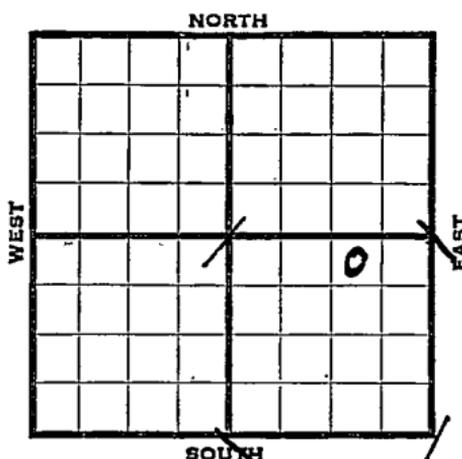

1939	REPORT
4/26	Mat'l.
5/5	10" - 196' Anhy 600'
	Drlg. 1125'
5/12	Drlg. 2367'
5/19	Topeka 2830' Drlg. 3146'
5/26	Lans. 3130' Arb. 3650'
	5" - 3655' T.D. 3658' S.O.
	RUST.
6/1	H.F.W. after drilling plug.
	baker plug 3450 to 3435'
	Lans. Pay 3361-72, 96 shots
	3356-72, 1000 acid.
	Estimated 100 bbis. per hour.
	27. Gravity at 71°
6/8	" " " "
6/16	Potential 881 bbis., Flow.
	OVER

1939
6/21

Arb. 3650'
5" - 3655'
Trans. 3130'
T.D. 3658'
P. B. to 3450'
1000 acid.
96 shots 3356-72'
Pump, 881 bbls., potential.

COMPLETED

Map No. 46 Sec. 35 Twp. 21 R. 12WWell No. 1 TeichmannTrigg Drlg. & Tom Allen Company

Contractor

FIRST REPORT

NW NE SE

330 Ft. from N. Line

_____ Ft. from S. Line

990 Ft. from E. Line

_____ Ft. from W. Line

SECTION PLAT

		Shell FO	
		/	o

MISCELLANEOUS

Location _____

Rig up _____

Drilling and Remarks:
Matl.

RECORD

Cased _____ in., _____ ft.

Sand _____

Gas _____

Oil _____

Total Depth _____

PRODUCTION

1st 24 hrs. Nat. _____

1st 24 hrs. after shot _____

Gas _____ Cu. Ft.

Dry Hole _____

Abandoned _____

Date

APR 26 1939 19H. D. Hatfield Scout

Misc. Small Maps	<i>RAY</i>
Cards	<i>RAY</i>
Tracing	<i>RAY</i>
France Map	<i>RAY</i>
Scarborough Map	<i>RAY</i>
Moody Map	<i>RAY</i>
Geological Dept.	<i>RAY</i>
Moody Plat Book	<i>RAY</i>

Map No. _____ Sec. **35** Twp. **21** R. **12W**Well No. **1 Teichmann****Trigg Drlg. & Tom Allen** Company

Contractor

COMPLETED**330** NW NE SE
Ft. from N. Line

_____ Ft. from S. Line

990 Ft. from E. Line

_____ Ft. from W. Line

SECTION PLAT

			o

MISCELLANEOUS

Location _____

Rig up _____

Drilling and Remarks:

*Ar 3650**5" @ 3650**Lane 3130**P.B. 3450**1000 acid**96 shots 3356-72**Pump 581 P.S.***RECORD**

Cased _____ in., _____ ft.

Sand _____

Gas _____

Oil _____

Total Depth *2650***PRODUCTION**

1st 24 hrs. Nat. _____

1st 24 hrs. after shot _____

Gas _____ Cu. Ft.

Dry Hole _____

Abandoned _____

Date

JUN 21 1939

19

S. J. LEWIS Scout

Misc Small Maps	Ray
Cards	Ray
Tracing	Ray
France Map	Ray
Scarborough Map	Ray
Moody Map	
Geological Dept.	
Moody Flat Book	