


Section 35 Township 21 S Range 12 W

Well No. #1 Teichman "D"

Company Petroleum, Inc.

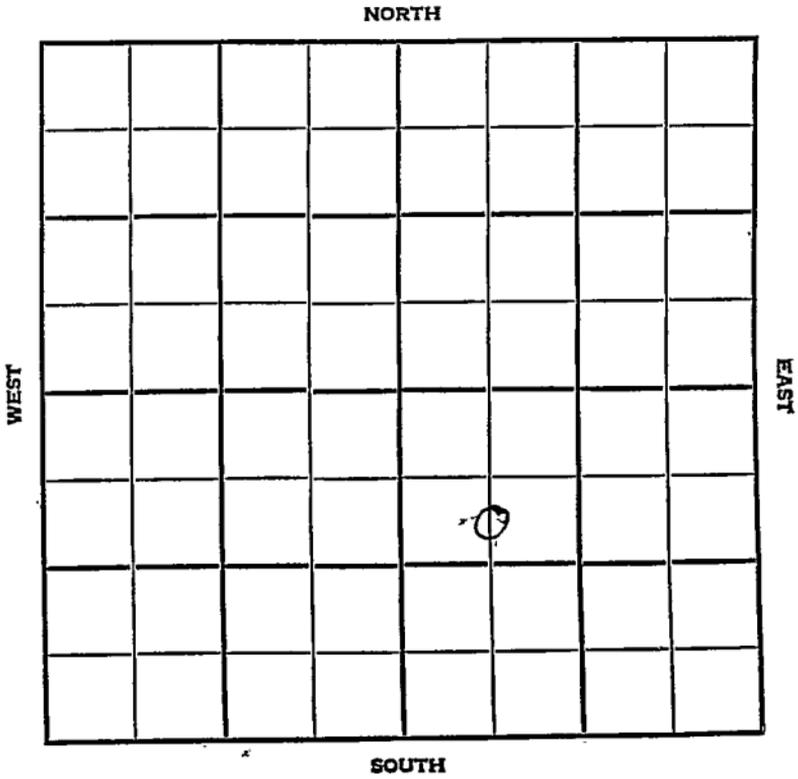

SEC. 35	TWP. 21S	R. 12W
------------	-------------	-----------

WELL NO.

#1 Teichman "D"

FARM

COMPANY

Petroleum Inc.

CONTRACTOR

Harvey


Max

\_\_\_\_\_ Ft. from N. Line

\_\_\_\_\_ Ft. from S. Line

\_\_\_\_\_ Ft. from E. Line

\_\_\_\_\_ Ft. from W. Line

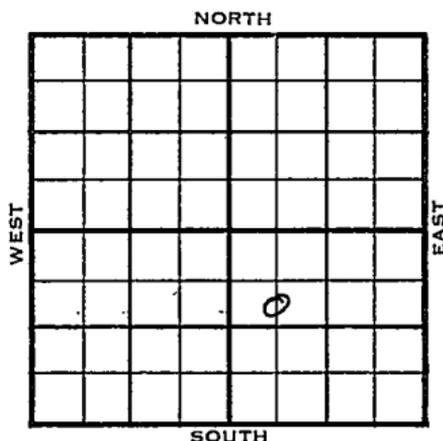S $\frac{1}{2}$  NW SE

	ELEVATION	REPORT
1955	1822'	
9/28	WOR	
11-23	Comm. 10-6-55 8 5/8" @ 283/200 DST 3365-85 op 1 hr. rec. 100' ocmsw 910/30" DST 3577-84 op 1 hr. rec. 1440' oil, 550/20" 5 1/2" @ 3580/200 CO to 3584 FU 1000' oil 4 hr. S/ 2 3/4 BOPH 9 hr., 1000 A S/ 4 1/4 BOPH DD 3586, 2000 A 6 1/3 boph 4 hr. Comp. 79 BOPD. H. 3089' Tr. 3109 Dg. 3122 B.L. 3221' L. 3243 A 3576 TD3586'	

COMPLETED

County Stafford Elev. \_\_\_\_\_  
 Sec. 35 Twp. 21S Rge. 12W  
 Company Petroleum, Inc.  
 FarmName Teichman "D" No. 1

TOPS	DEPTH	LOG	DATUM
Anh.			
Tr.			
H.			
Tr.			
Dg.			
BL.			
L.			
K.C.			
B.K.C.			
Ce.			
C.			
M.			
M.			
K.			
Mz.			
Mq.			
V.			
S.			
S.			
A.			
R.			
PE.			
G.			
T.D.			

Loc. in Sec. S<sup>1</sup> NW SE  
~~ES - S<sup>1</sup>/<sub>2</sub> & NW<sup>1</sup>/<sub>2</sub>~~  
~~of S<sup>1</sup>/<sub>2</sub>~~  
 Geol. \_\_\_\_\_  
 Contr. Garvey  
~~Rig #15~~  
 Pool \_\_\_\_\_  
Max  


 FIRST REPORT  
 o  
 \_\_\_\_\_

Date Comm. SEP 28 1955  
WOR from San Diego #3 Pierpont 35-26S-13W

3

Co. No. Sec. T. R.

County Stafford Elev. 1822  
 Sec. 35 Twp. 21 Rge. 12W  
 Company Petroleum Inc.  
 Farm Name Teichman "D" No. 1

Co.

Lse.


No.

Sec.

T.

R.

TOPS	DEPTH	LOG	DATUM	Loc. in Sec.
Anb.				C S $\frac{1}{2}$ NW SE
Tp.				
H.	3089		1267	
Tr.	3109		1287	
Dg.	3122		1300	
Bl.	3221		1399	
L.	3243		1421	
K.C.				Geol.
B.K.C.				Contr.
Ce.				Garvey
C.				Pool
M.				Max
M.				
K.				
Mz.				
Mo.				
V.				
S.				
A.	3576		1754	COMPLETE
R.				
Pe.				
G.				
T.D.	3584			

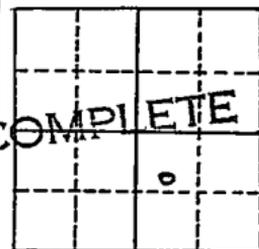

Date Comm. 10-6-55 NOV 23 1955  
 8 5/8" @ 283/200 DST 3365-85 open 1 hr  
 rec. 100' ocmsw 910/30" DST 3577-84  
 open 1 hr. rec. 1440' oil 550/20"  
 5 1/2" @ 3580/200 CO to 3584 FU 1000' oil  
 4 hr. S/ 2 3/4 boph 9 hr. 1000 A  
 S/ 4 1/4 boph DD 3586 2000 A  
 6 1/3 boph 4 hr. Comm. 79 boph