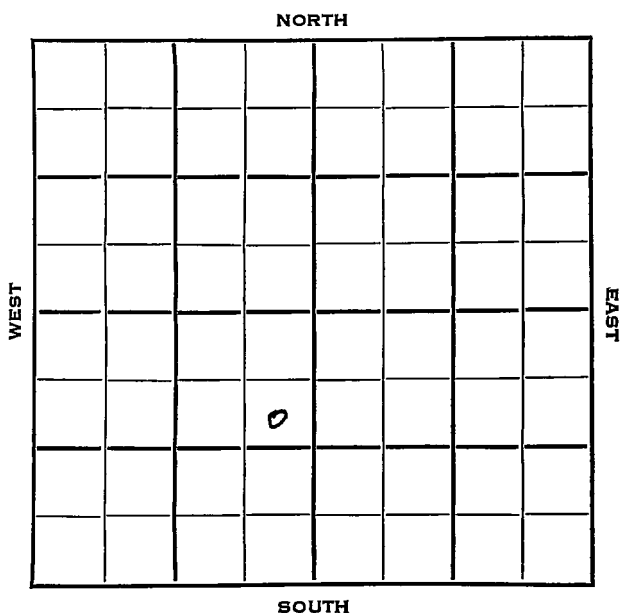


Section 35 Township 21 Range 13WWell No. 4 DrachCompany Sohio Petr.

Stafford

KANSAS

SEC.	TWP.	R.
35	21	13W ✓

WELL NO.

#4 Drach

FARM

COMPANY

Sohio Pet.

CONTRACTOR

Musgrove

Gates Pool

990


Ft. from N. Line

Ft. from S. Line

330

Ft. from E. Line

Ft. from W. Line

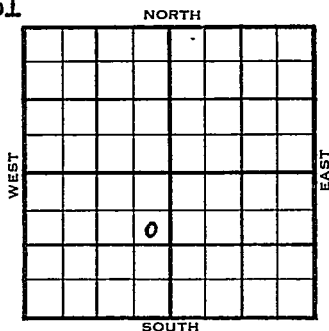

SE NE SW

1953

ELEVATION

1880'

REPORT

11/4

M I R

11/11

8" @ 256' w/200 sks

Anhy 715'

Drlg 2905'

11/18

Spud 11-5-53

D&A

TD 3730'

8-5/8" @ 256'

Anhy 715', Heeb 3190', Tor 3213', Br.

Lime 3320', Lans 3337'

DST 3352-80, opn 1 hr., rec. 8' mud,

DST 3420-40', opn 1 hr., rec. 15' mud,

740#

DST 3456-68', opn 1 hr., rec. 25'

vsocm, 950#

DST 3474-3505', opn 1 hr., rec. 14'

mud

Viola 3594'

DST 3596-3619', opn 1 hr., rec. 15'

mud

DST 3616-41', opn 1 hr., rec. 15' mud

0#

Simp. 3642', arb. 3697'

DST 3697-3705', opn 1 hr., rec. 25'

mud,

TD 3730'

D&A

ABANDONED

J. G. McGEHEE

NOV 6 1953

Scout Cards	
& Small Maps	
and Wall Maps	
Postings	
Frank's Map	
Dr. B. A. M. P.	
Misc.	

Drig. Data

J. G. McGEHEE

NOV 24 1953

Scout Cards	
Land Small Maps	
Land Wall Maps	
Tracings	
France Map	
Pierre Map	
Misc.	

Orig. Date