


Stafford **KANSAS**

SECTION 35 TOWNSHIP 21 RANGE 13 W

WELL NO. #5 Applegate

COMPANY H. G. Kaiser

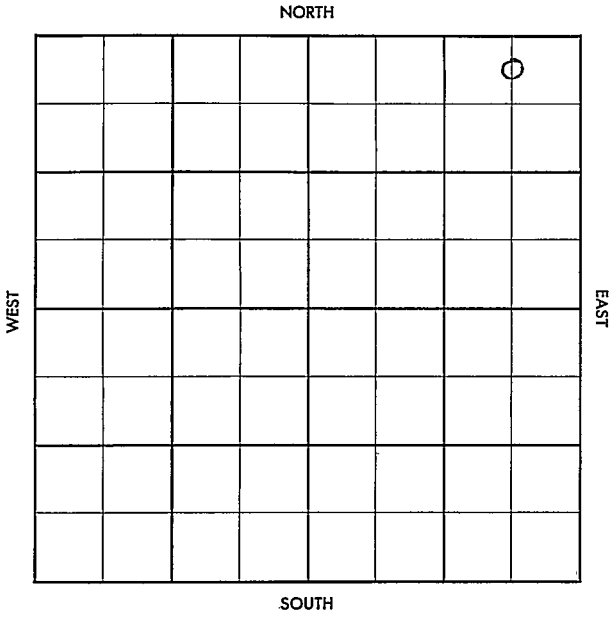

Stafford

KANSAS

SEC. 35	TWP. 21	R. 13W
------------	------------	-----------

WELL NO. #5 Applegate FARM
COMPANY

CONTRACTOR H.G. Kaiser

Gates


_____ Ft. from N. Line

_____ Ft. from S. Line

_____ Ft. from E. Line

_____ Ft. from W. Line

C N $\frac{1}{2}$ NE NE

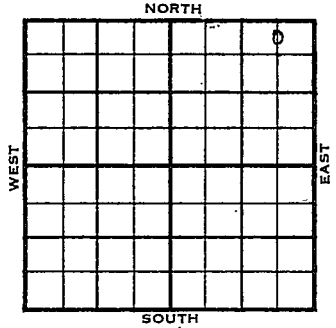

1955	ELEVATION	REPORT
------	-----------	--------

12-14 Location

County Stafford Elev. _____
 Sec. 35 Twp. (21) D Rge. 13W
 Company H. G. Kaiser
 FarmName Applegate No. 5

TOPS	DEPTH	LOG	DATUM
Anh.			
Tp.			
H.			
Tr.			
Dg.			
Bl.			
L.			
K.C.			
B.K.C.			
Ce.			
C.			
M.			
M.			
K.			
Mz.			
Me.			
V.			
S.			
S.			
A.			
R.			
Pe.			
G.			
T.D.			

Loc. in Sec. C N¹/₂ NE NE

Geol. _____

Contr. _____

Pool _____

Gates

			<input checked="" type="checkbox"/>
FIRST REPORT			
DEC 14 55			

Date Comm. _____

Location

T. Co.

L. Sec.

No.

Sec.

T.

R.

DEC 23 1955

R. G.

County Stafford Elev 1875
 Sec. 35 Twp. 21 Rge. 13W
 Company H. G. Kaiser
 Farm Name Applegate No. 5

TOPS	DEPTH	LOG	DATUM	Loc. in Sec.
Ans.				C N $\frac{1}{2}$ NE NE
Tp.				
H.	3173			
Tf.				
Dg.				
Bl.	3297		1422	
L.	3315		1440	Geol.
K.C.				Conts. <u>Almaur</u>
BXC.	3553		1678	
Ce.				
C.				Pool
M.				Gates
K.				
Mz.				
Ma.				
V.	chest 3561		1686	
S.	3606		1731	
S.				
A.	✓ 3655		1780	
R.				
Pe.				
G.				
TD	3670			

FEB 22 1956

Date Comm.

Location DEC 21 '55 Gas DEC 28 ✓ JAN 5 '56JAN 11 '56 MIRT JAN 18 '56 1-10-568578 278/200 ID 3250 JAN 25 '56DST 3328-62 1hr 150' GCWM BHP 380115 DST 3378-3401 1hr rec 30' 50CMBHP 310/20 DST 3424-51 1hrrec 25' 50G5W BHP 0/15 DST 3494-3540 1hr rec 45' WCM BHP 0/20DST 3656-60 1hr rec 20' Md BHP 0/15

MAR 1 1956

R. G.

DST 366-00 1hr 1680' good
net 30' SACM # 70' WHOCM # 50'
01' BHT 400/22 5' 12 3657/
FEB 1 56 Co 3670 fst 1 1/2 Bopk
DD 3672 TP fst 2 Bopk
n/w Ave # 9 Bopk notes
8 hr 15 R FEB 8 56 W.O. pump
WIT FEB 18 56 Pap FEB 22 56 XP 40
Bopk n/w gran exp 38°