


Section 35 Township 21 Range 13 W

Well No. # 6 Mattie Gates "B"

Company Magnolia Pet.

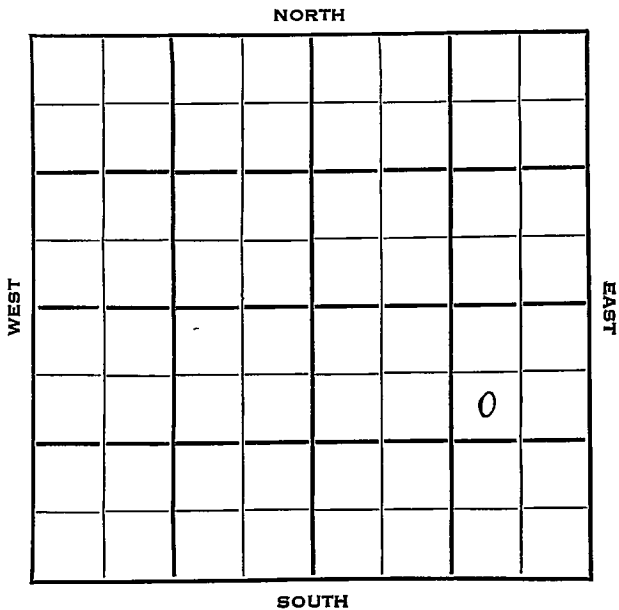

Stafford


NSAS

SEC.	TWP.	R.
35	21	13W

WELL NO. #6 Mattie Gates "B" FARM

COMPANY

CONTRACTOR Magnolia Pet.

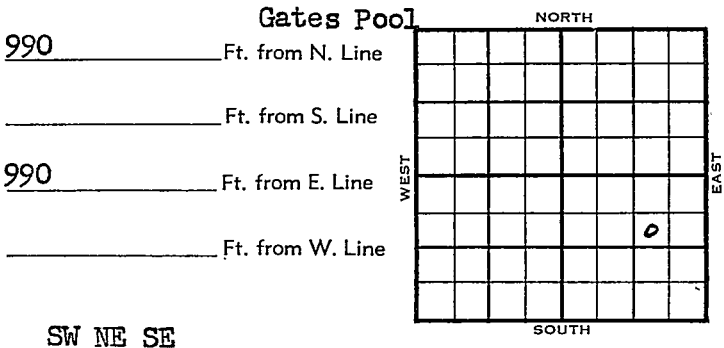

	ELEVATION	REPORT
1953	1879'	
11/30	Location	
12/9	9" @ 261' w/250 sks Drlg. 2440'	
1954		
1/6	Spud 12-4-53 Oil Well TD 3745' 9" @ 261' Heeb 3174', Br. Lime 3304', Lans 3320' DST 3334'-80' opn 1 hr, rec 60' hg & socm, 120' ho & gcm 480' gassy oil 1150# DST 3386'-93' opn 1 hr, rec 1010' gassy oil 5' hocm 1100# DST 3459'-65' opn 1 hr, rec 290' oil 1150# DST 3478'-3513' opn 1 hr, rec 360' ocm 60' hvy blk oil 745# VioIa 3570', Simp 3608', Arb 3654' DST 3690'-3705' opn 1 hr, rec 60' so & gcm 20' ho & gcm 10' sul wtr. 1110# TD 3745' 5" @ 3744' CO to 3710 60/ 3681-96 S/ 1 boph 15 hr. 250 mud-acid S/ 21 boph Comp 144 bopd 8% wtr.	

County **Stafford** State **Kansas**

Sec. **35** (Blk. Twp.) **21** (Sur. Rge.) **13W** Map No.

Operator **Magnolia Pet.**

Well No. **6** Farm **Mattie Gates "B"**

Elev. Location **SW NE SE**

FIRST REPORT					
				0	

**990** Ft. From **N** Line **SE**

**990** Ft. From **E** Line **Quarter**

Ist. Report **DEC 2 1953**

Completion

Remarks

Spudding Date

Drlg. Data **Gates Pool**

**Location**

