
FORM 51

Stafford KANSAS

Section 35 Township 21 Range 13W

Well No. 7 Mattie Gates "B"

Company Magnolia Petr.

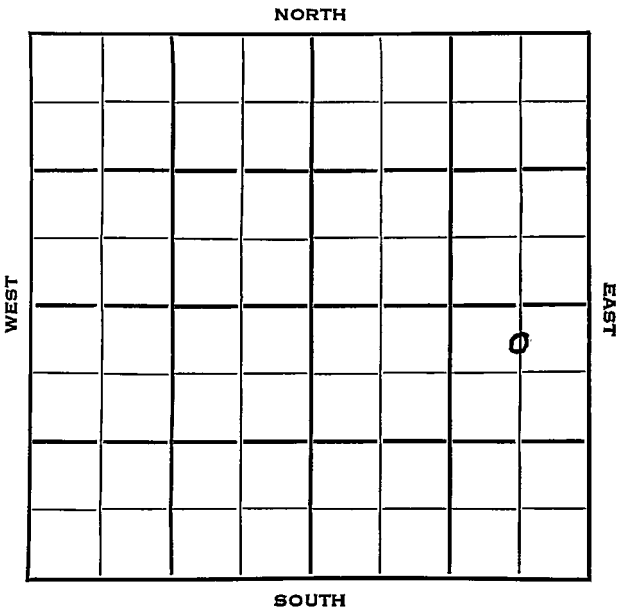

Stafford KANSAS

SEC.	TWP.	R.
35	21	13W

WELL NO.

#7 Mattie Gates "B" FARM

COMPANY

Magnolia Pet.

CONTRACTOR

Brack


Gates Pool

330 Ft. from N. Line

Ft. from S. Line

660 Ft. from E. Line

Ft. from W. Line

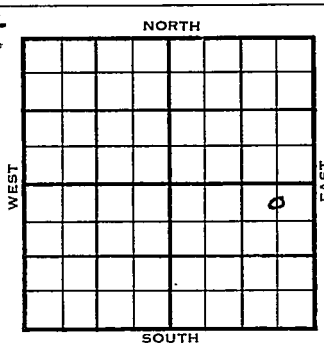

C N L NE SE

1954	ELEVATION 1876' REPORT
2/10	Spud 2-6-54 8" @ 266' Drlg 970'
2/17	Heeb 3174', Br li 3302', Lans 3319' DST 3322-53', 1 hr.,112' hg & socm, 560# DST 3356-82', 1 hr., 150' heavy oil 180' oil, 640# Drlg.3455'
2/24	V 3568', Simp 3606', Arb. 3657' RTD 3746' 5" @ 3745', CO 3720', 40/3682-92, 1/2 boph 4 hrs., 104/3656-82, S/3½ boph 4 hrs.
3/3	Spud 2-6-54 Oil Well TD 3746' 8" @ 266' Heeb 3174', Br. Lime 3302', Lans 3319' DST 3322'-53' opn 1 hr, rec 112' hg & vsocm 560# DST 3356'-82' opn 1 hr, rec 150' heavy oil, 180' oil, 640# Viola 3568', Simp 3606', Arb 3657'

OVER

DX-78

1954

Information brought forward.

3/3 TD 3746'
5" @ 3745'
CO to 3720'
40/ 3682'-92' B/ ½ boph 4 hr.
104/ 3656'-82' S/ 3½ boph 4 hr.
P/ 65 bo
Comp 163 bopd.

COMPLETED

FORM 275 FOR SALE BY KANSAS BLUE PRINT CO.


County Stafford State Kansas

Sec. 35 (Blk. Twp.) 21 (Sur. Rge.) 13W Map No.

Operator Magnolia Pet.

Well No. 7 Farm Mattie Gates "B"

Elev. Location C N L NE SE

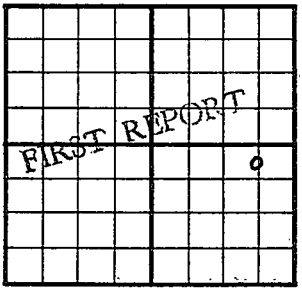

330 Ft. From N Line SE

660 Ft. From E Line Quarter

FEB 10 1954

1st. Report

Completion

Remarks


Brack - Contr.

Spudding. Date 2-6-54

Drlg. Data Gates Pool

8" @ 266 drlg. 970

J. G. McGEHEE

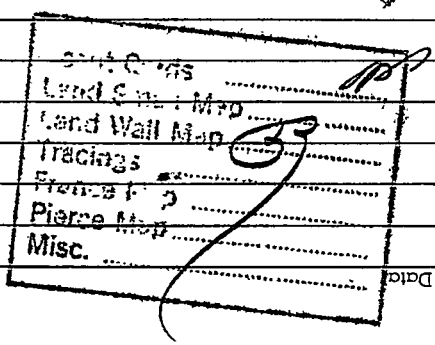
FEB 11 1964
Land Wall Map
Tracings
Misc.

FORM 275 FOR SALE BY KANSAS BLUE PRINT CO.


County Stafford State Kansas

Sec. 35 (Blk. Twp.) 21 (Sur. Rge.) 13W Map No.

Operator Magnolia Pet.

Well No. 7 Farm Mattie Gates "B"

Elev. 1876 Location C N L NE SE

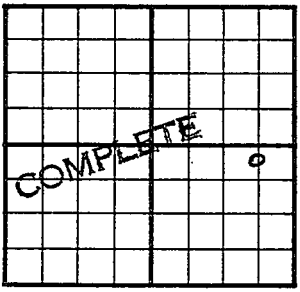

330 Ft. From N Line SE

660 Ft. From E Line Quarter

1st. Report

Completion MAR 3 1954

Remarks Gates Pool
Brack - Contr.

Spudding Date 2-6-54

Drlg. Data Oil well TD 3746

8" @ 266 Heeb. 3174 Br. lime 3302

Lans. 3319 DST 3322-53 open 1 hr.

Rec. 112' hg & vsocm 560# DST 3356-82

open 1 hr. Rec. 150' heavy oil 180' oil

640# Viola 3568 Simp. 3606

Arb. 3657 TD 3746 5" @ 3745

CO to 3720 40/ 3682-92 B/ ½ boph 4 hr.

104/ 3656-82 S/ 3½ boph 4 hr. P/ 65 bo

Comp. 163 bopd

J. G. McGEHEE

MAR 8 1954

Scout Cards	
Land Small Map	
Land Wall Map	
Tracings	
France Map	
Pierce Map	
Misc.	

Drlg. Data