
KANSAS Stafford

FORM 51 25M 3-49 PETROL

Section 35 Township 21 Range 14-W

Well No. #1 Metzek

Company Petroleum Inc.

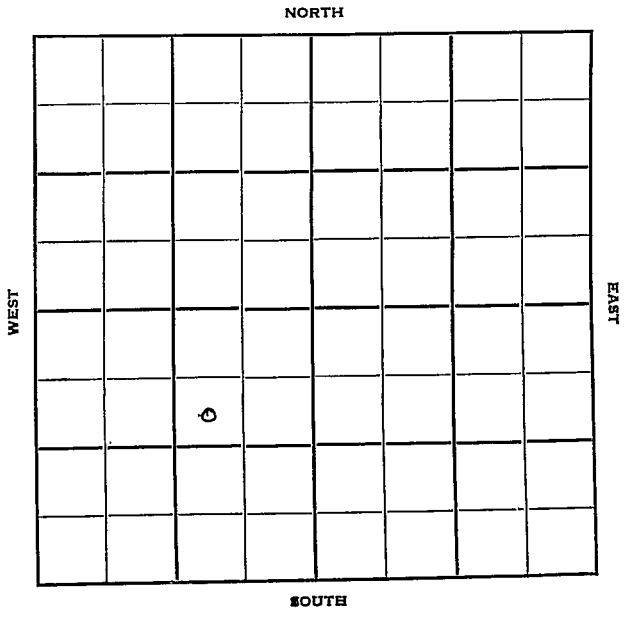

FORM 252-B
10M 9-49 PETROL

KANSAS

Sec. 35 Twp. 21 Stafford R. 14W

Well No. #1 Metzek Farm

Petroleum, Inc. Company

Contractor

Wildcat


990' Ft. from N. Line

Ft. from S. Line

990' Ft. from E. Line

Ft. from W. Line

SW NE SW

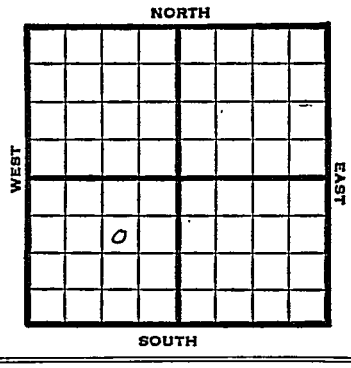

1950	REPORT
	Elev 1934
5/24	Spud 5-21-50 8-5/8" @ 240' Drlg. 1800'
5/31	8 5/8" @ 240 Heeb 3291 Br Lime 3412 Cong 3680 Arb 3794 TD 3825 D&A

ABANDONED

Form 26 200 Bks. 11-49 Petrol Kansas Wildcat

Map No. ____ Sec. 35 Twp. 21 R. 14W

Well No. 1 Metzek

Petroleum Inc. Company

Contractor

SW NE SW


SECTION PLAT

990 Ft. from N. Line

Ft. from S. Line

990 Ft. from E. Line

Ft. from W. Line

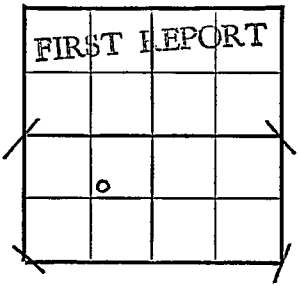

Stafford

Location

Rig up

Drilling and Remarks:

Spud 5-21-50

8 5/8 @ 240

Drlg. 1800

RECORD

Cased in., ft.

Sand

Gas

Oil

Total Depth

PRODUCTION

1st 24 hrs. Nat.

1st 24 hrs. after shot

Gas Cu. Ft.

Dry Hole

Abandoned

Date

MAY 24 1950 19

J. E. TYRA Scout

Form 26 200 Bks. 11-49 Petrol

Wildcat

Kansas

Map No. _____ Sec. 35 Twp. 21 R. 14W

Well No. 1 Metzek


Petroleum Inc. Company

Contractor

SW NE S[illegible]

El. 1734

SECTION PLAT

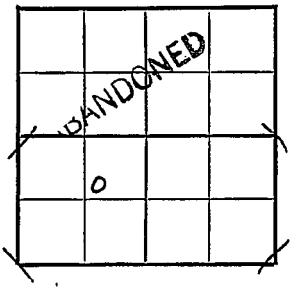

990 Ft. from N. Line

Ft. from S. Line

990 Ft. from E. Line

Ft. from W. Line

Stafford

Location

Rig up

Drilling and Remarks:

8 5/8" C 240
Neb. 3291
Br lime. 3412
Lans. 3422
Cong. 3680
Arb. 3794
T.D. 3825

RECORD

Cased in., ft.

Sand

Gas

Oil

Total Depth 3825

PRODUCTION

1st 24 hrs. Nat.

1st 24 hrs. after shot

Gas Cu. Ft.

Dry Hole

Abandoned

Date D & A

MAY 31 1950 19 J. E. TYRA Scout