


Section 35 Township 21 Range 14 W

Well No. # 1 Spangenberg

Company Glenn Nye Drlg.

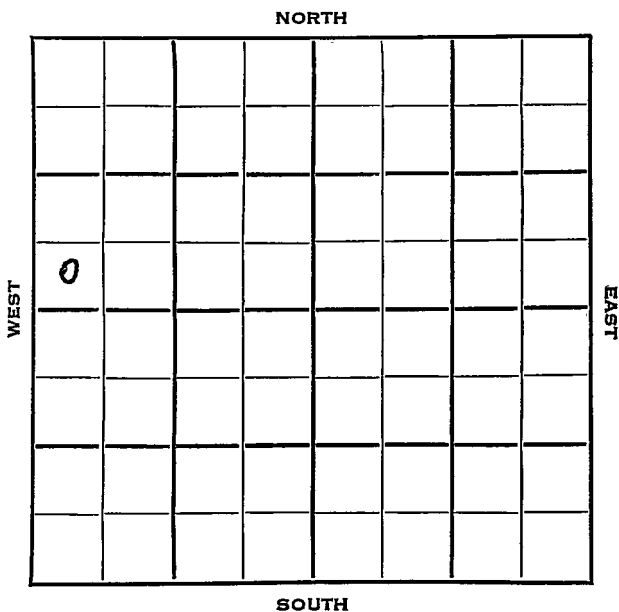

Stafford

KANSAS

SEC.	TWP.	R.
35.	21	14W

WELL NO. 1 Spangenberg FARM

COMPANY Glenn Nye Drlg.

CONTRACTOR Glenn Nye
Hickman Pool

	Ft. from N. Line	
330	Ft. from S. Line	
	Ft. from E. Line	
330	Ft. from W. Line	

SW SW NW

1953	ELEVATION 1936'	REPORT
------	-----------------	--------

10/21	Spud 10-14-53 8" @ 435 Anhy 835 Drlg. 2649'
10/28	TD 3610 D&A
11/4	Spud 10-14-53 D & A TD 3610' 8" @ 435' Anhy 835, Heeb 3300, Tor 3322, Br. Lime 3421', Lans 3431', TD 3610' D & A

ABANDONED

