


Section 35 Township 21 Range 16 W

Well No. # 2 Prosser (B)

Company Iron Drlg.

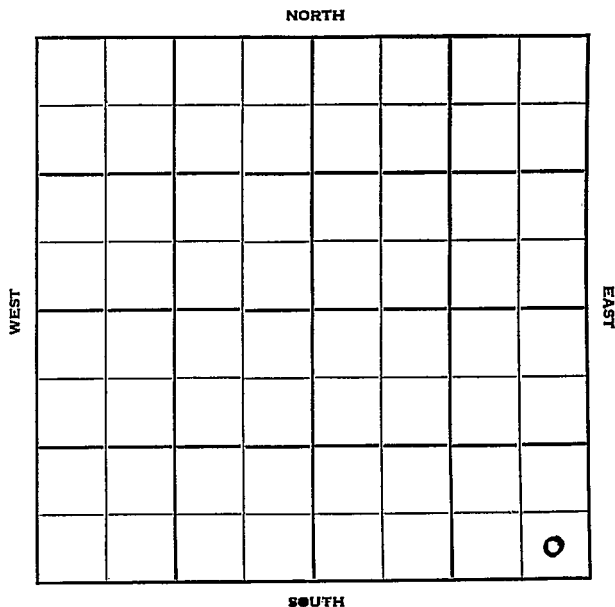

Sec. 35 Twp. 21 R. 16W

Well No. #2 Prosser (B) Farm

Iron Drlg. Company

Iron Drlg. Contractor


_____ Ft. from N. Line

330 Ft. from S. Line

330 Ft. from E. Line

_____ Ft. from W. Line

SE SE SE

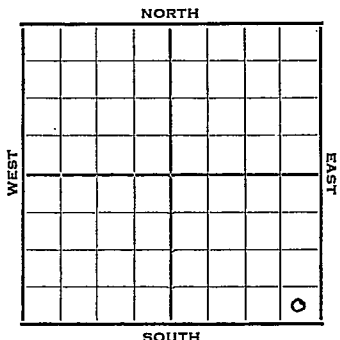

1952

Elev. 1981' REPORT

6/25

Spud 6-15-52
 Anhy 958' 10" @ 959'
 Br L 3489 Lans. 3497
 Simp. 3851 Simp. sd 3855
 DST 3844-57, 1 hr. 420' O&GCM
 1200# RTD 3857'
 7" @ 3855' WOCT

7/2

RUST Shut down

7/9

DD 3857' TD S/1½ BOPH

7/17

NR

7/23

"

7/30

P/40 Bopd

8/6

Spud 6-15-52
 Oil Well TD 3857
 Anhy 958 10" @ 959
 Br Line 3489 Lans. 3497
 Simp 3851 Simp sd 3855
 DST 3844-57 opn 1 hr. Rec. 420'
 o & gcm 1200# TD 3857
 7"@ 3855 DP to 3857 S/1½ boph
 P 40 bopd Comp. 51 bopd
 7% wtr.

3851
 1981
 1870

COMPLETED

