


Section 35 Township 21 Range 16W

Well No. #4 Prosser "B"

Company Iron Drlg. et al

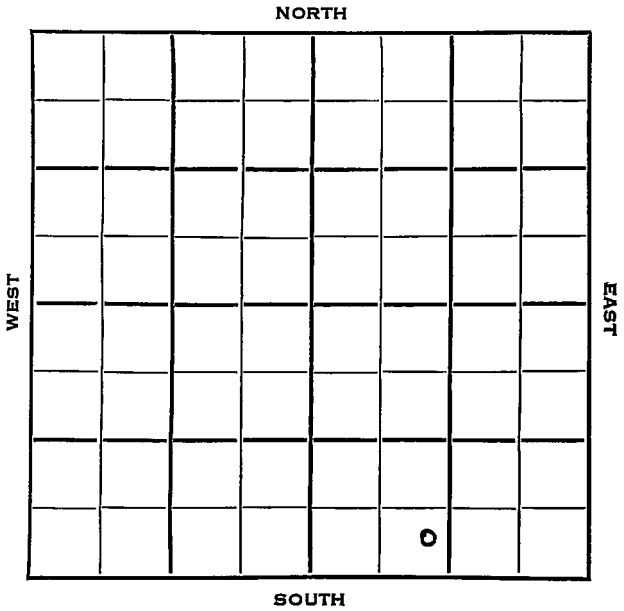

Sec. 35 Twp. 21 R. 16 W

Well No. # 4 Prosser #B# Farm

Iron Drlg. et al Company


Iron Drlg. Contractor

_____ Ft. from N. Line

450 Ft. from S. Line

1500 Ft. from E. Line

_____ Ft. from W. Line

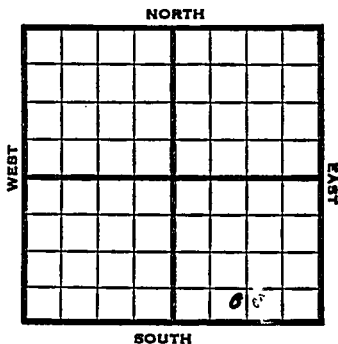

SE SW SE

1953 Elev. 1987' REPORT

- 8/19 Spud 8-4-53
8" @ 940 Anhy 940'
Drlg. 3750'
- 8/26 NR
- 9/9 Heeb 3386, Br. L. 3499', B KC 3745'
- 9/16 Spud 8-4-53
Oil Well
TD 4184
8" @ 940
Anhy 940, Lans 3505, Cong 3814,
Viola 3826, Simp 3686', Arb. 3927
DST 3859-72, opn 1 hr., rec. 30'
mud & VSSO, 120#
DST 3868-72, opn 1/2 hrs., rec. 7'
mud
DST 3870-77, opn 1 hrs., rec. 45'
socm, 320#
35/3872-84, 20/3814-19, S/5 boph &
SSW
S/10 boph
Heeb 3386, Br lime 3499, B KC 3745
TD 4184
5" @ 4180
Comp. 318 bopd

COMPLETED

