


Section 35 Township 21 Range 16 W

Well No. # 6 Prosser "B"

Company Iron Drlg.

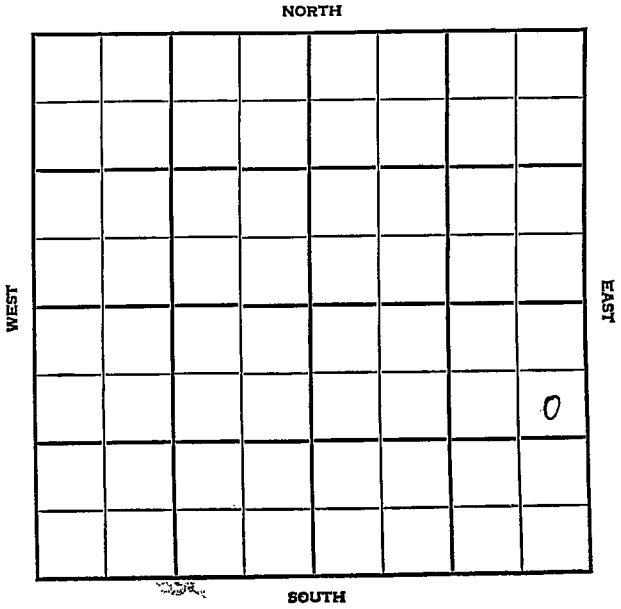

Pawnee KANSAS

SEC.	TWP.	R.
35	21	16W ✓

WELL NO. 6 Prosser "B" FARM

COMPANY

CONTRACTOR Iron Drlg.

Iron Drlg.


Evers Drlg.

990 Ft. from N. Line

_____ Ft. from S. Line

330 Ft. from E. Line

_____ Ft. from W. Line

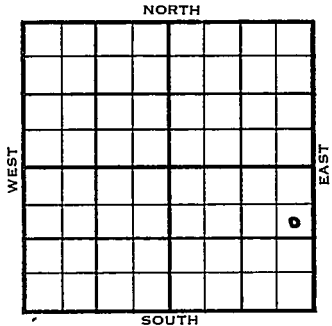

SE NE SE

	ELEVATION	REPORT
1954	1976	

5/19 Spud 5-10-54
8" @ 955'
Drlg. 3238'

5/26 Drlg. 4177' for S OD
6/2 NR

6/9 Spud 5-10-54
SWD Well
TD 4246'
8" @ 955'
KC 3509', Cong 3819'
DST 3819-50', opn 1 hr., rec. 1950'
wtr,
Simp. sh. 3882'
DST 3855-75', opn 1/2 hrs., rec. 505'
wtr
Arb. 3944'
TD 4246'
5" @ 3980'
CO to 4246'
Comp. for SWD Well

ABANDONED

