

Pawnee KANSAS

DX 78-1


Section 35 Township 21 Range 16W

Well No. 1 Hutcherson

Geo. Seigrist

Company _____

NORTH

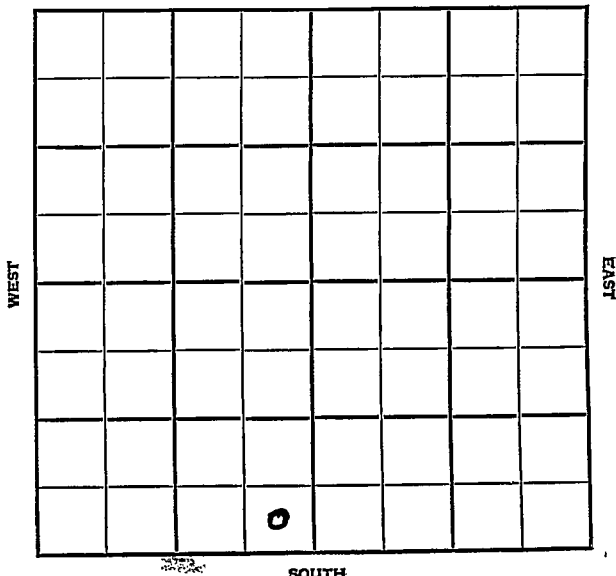

SOUTH

Pawnee KANSAS

SEC.	TWP.	R.
35	21	16W


WELL NO. 1 Hutcherson FARM

COMPANY Geo. Seigrist

CONTRACTOR Musgrove

Evers Pool

_____ Ft. from N. Line
 330 _____ Ft. from S. Line
 330 _____ Ft. from E. Line
 _____ Ft. from W. Line

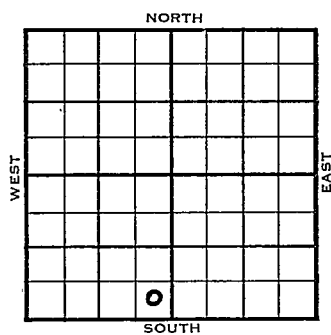

SE SE SW

1954	ELEVATION	REPORT
	1985	
7/28		Spdg 7-22-54 8" @ 990
8-11		Drlg. 2050 Spdg 7-22-54 D&A TD 3980 8" @ 990 Heeb 3409 KC 3548 DST 3545-75 open 1 hr. Rec. 55' gcm 500# DST 3624-35 oepn 35 min, Rec. 8' mud Cong. 3826 Simp. sh. 3898 Simp. sd. 3922 Arb. 3973 TD 3980 D&A
ABANDONED		

