

DX 78-1


Pawnee

KANSAS

Section 35 Township 21 Range 16 W

Well No. # 1 Prosser

Company Duke & Wood

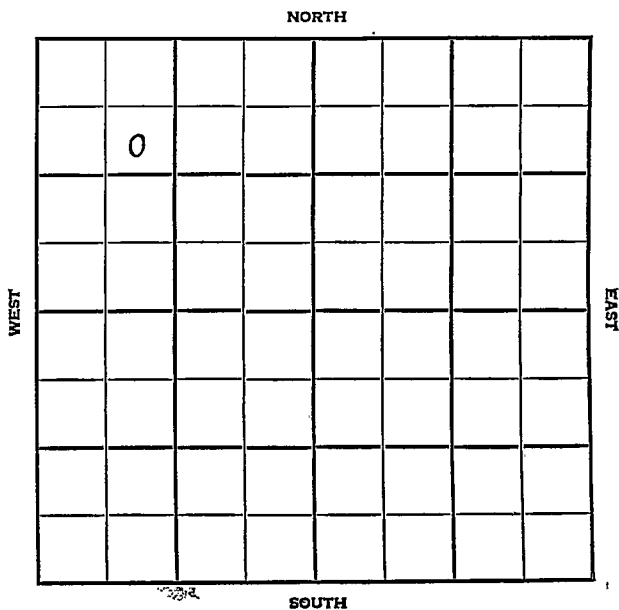

* Pawnee KANSAS

SEC.	TWP.	R.
35	21	16W ✓

WELL NO. 1 Prosser FARM

COMPANY

CONTRACTOR Duke & Wood

Duke & Wood


Evers Pool

1100 Ft. from N. Line

_____ Ft. from S. Line

_____ Ft. from E. Line

900 Ft. from W. Line

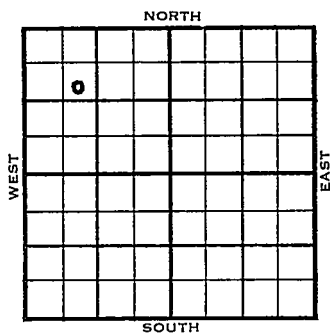

SE NW NW

	ELEVATION	REPORT
1954	1982'	

5/19 Spud 5-13-54
 Anhy 982'
 8" @ 985'
 Drlg. 3000'

5/26 Spud 5-13-54 D & A TD 3938
 Anhy 982 8" @ 985 Heeb 3397
 Lans. 3509 Cong. 3797 Viola 3808
 DST 3783-3825 open 1 hr rec 15' mud
 SSO off Simp. 3875 TD 3938
 D & A

ABANDONED

County Pawnee State Kansas

Sec. 35 (Blk. Twp.) 21 (Sur. Rge.) 16W Map No.

Operator Duke & Wood

Well No. 1 Farm Prosser

Elev. 1982 Location SE NW NW

	o				

1100 Ft. From N Line NW
 900 Ft. From W Line Quarter

1st. Report

Completion MAY 26 1954

Remarks Evers Pool
 Duke & Wood - Contr.

Spudding Date 5-13-54

Drig. Data D & A TD 3938

Anhy 982 8" @ 985 Heeb. 3397

Lans. 3509 Cong. 3797 Viola 3808

DST 3783-3825 open 1 hr. Rec. 15' mud

SSO 0# Simp. 3875 TD 3938

D & A

J. G. MCGEHEE