


SECTION 35 TOWNSHIP 21S RANGE 34WWELL NO. #1-GoblemanCOMPANY Nate Appleman

C NE NE

NORTH

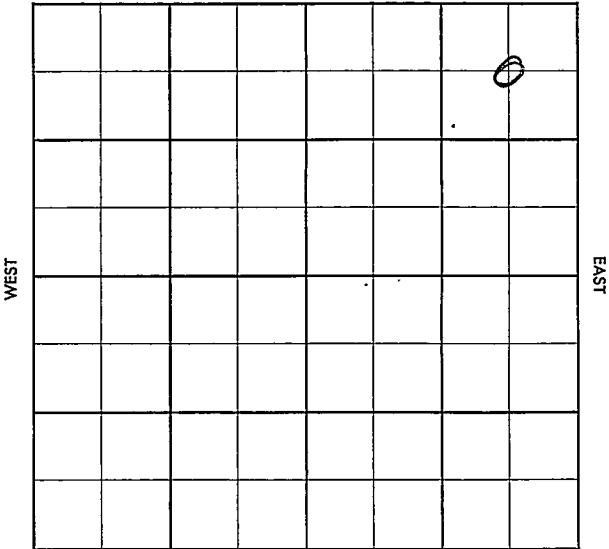

SOUTH

	TOPS	DEPTH	LOG	DATUM	Loc. in Sec.
Anh.					C NE NE
Tp.					
H.					
Tr.					
Dg.					
BL.					
L.					Geol.
K.C.					
B.K.C.					Contr.
Ce.					Garvey
C.					
M.					Pool
M.					Hugoton
K.					
Mz.					
Me.					
V.					
S.					
S.					
A.					
R.					
Pe.					
G.					
TD.					

Lse.

No.

JUL 24 '57 O
 FIRST REPORT

Location

T.
R.

CORRECTION

S-513-A

CORRECTION

CO. Finney ELEV. _____
SEC. 35 TWP. 21 RGE. 34W
COMPANY Nate Appleman NO. 1

CORRECTION

SEP 25

FARM Gobleman

LOC. C NE NE

GEOL. _____

CONTR. _____

POOL Hugoton

SPUD _____

Comp. 72/20 2,300 mcf/gpd RD 435#

CO.

LSE.

NO.

SEC.

TWP.

RGE.

County Finney Elev. 2928 D A
 Sec. 35 Twp. 21 Rgs. 34W
 Company Nate Appleman
 Farm Name Gobleman No. 1

TOPS	DEPTH	LOG	DATUM	Loc. in Sec.
Anh. <u>Herr</u>	<u>2564</u>			<u>C NE NE</u>
Tr. <u>RCL</u>	<u>2578</u>			
H. <u>WFD</u>	<u>2614</u>			
Tr.				
Dg.				
BL				
L.				Geol.
K.C.				Contr.
B.K.C.				<u>Garvey</u>
Ce.				Pool
C.				<u>Hugoton</u>
M.				
M.				
K.				
Mz.				
Mo.				
V.				
S.				
S.				
A.				
R.				
Pe.				
G.				
TD.	<u>2570</u>			

COMPLETE

OCT 2 57

Date Comm.

Location NE 31 57 7-22-57 85/8245/200 5 1/2 2569/100 WOCT AUG 8 57DD 2243 ga 44 MCLF PB 2590FRAC 10 X 10 ga 1 Mill CFL AUG 14 57AUG 21 57 AUG 28 57 SEP 4 57 SEP 11 57SEP 18 57 ga 300 MCLFOCT 2 572,300 MCLF pdRP 436