

KANSAS


FORM 51 5M 1-42 PETROL

Finney

Section 35 Township 21 Range 34-W

Well No. #1 Globeman "B"

Company Atlantic

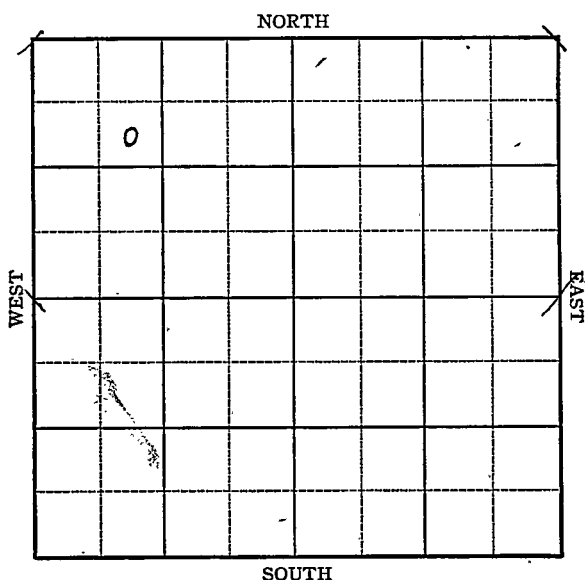

KANSAS**Finney**Sec. 35 Twp. 21 R. 34 ^WWell No. #1 Globeman "B" FarmAtlantic Company

Nunn

990

Ft. from N. Line


Ft. from S. Line

Ft. from E. Line

990

Ft. from W. Line

Elev. 2946

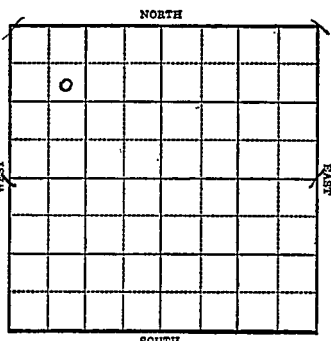

1943

R E P O R T

7/14 Derrick
 7/21 10" @ 256'
 Drlg. 2245'
 7/28 Drlg. 2921'
 8/4 Drlg. 3770'
 8/11 Lans. 3860
 Drlg. 4407'
 8/18 Sand 4608
 SO 4620-30
 Miss. 4640
 Coring 4662'
 8/25 T.D. 4725' Run 5"
 9/1 5" @ 4719' RUST
 9/8 " "

Running 1' higher on Miss. than Atlantic
 Producer #1 Gobelman in Center NE SE 27-21S-
 34W

Running 50' lower on Miss. than Atlantic
 producer #1 Nunn in Center SE NE 27-21S-34W.
 (Mr. Beekley)

9/15 228 shots 4648'-80'
 5000 gal. acid
 130' oil in 2 hrs.

OVER

1943
 9/22 10,000 gal. acid.
 Pump 33 oil per hr.
 9/29 Ripped casing 4648-80
 1000' oil.
 10/6 " "
 10/15 " "
 10/20 " 2
 10/27 " "
 11/3 T.D. 4791'
 Pump 67 oil in 18 hrs.
 11/10 Pump 13 oil & $1\frac{1}{2}$ water a day
 11/17 " " " " "
 12/8 Plug 4642 174 shots 4312-41
 200' oil 2 hrs
 500 Acid
 12/15 2800 acid
 Pump $4\frac{1}{2}$ oil per hr for 8 hrs.
 12/22 " " "
 " " "
 12/29 " " "
 1944
 1-5 " " "
 1/12 5" @ 4719
 Lans 3860
 Sand 4608
 TD 4791
 Perf. Sand & Lans
 9300 acid
 Pump 10 Pot.
 Gravity 36

COMPLETED

Fimney

KANSAS


Map No. 111 Sec. 35 Twp. 21 R. 34WWell No. 1 Globeman "B"Atlantic
FIRST REPORT

Company

Contractor

SE NW NW

SECTION PLAT

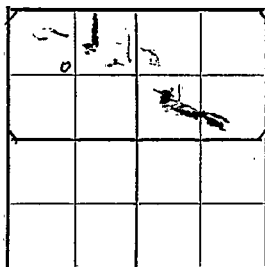990 Ft. from N. Line Ft. from S. Line Ft. from E. Line990 Ft. from W. Line

NUNN POOL

Location Rig up

Drilling and Remarks:

Derrick

RECORD

Cased in., ft.Sand Gas Oil Total Depth

PRODUCTION

1st 24 hrs. Nat. 1st 24 hrs. after shot Gas Cu. Ft.Dry Hole Abandoned

Date

JUL 14 1943

19

S. I. LEWIS Scout

KANSAS

Map No. 17M Sec. 35 Twp. 21 R. 34WWell No. 1 Gobleman "B"Atlantic

Company

COMPLETED

Contractor

SE NW NW

SECTION PLAT

990


Ft. from N. Line

Ft. from S. Line

Ft. from E. Line

990

Ft. from W. Line

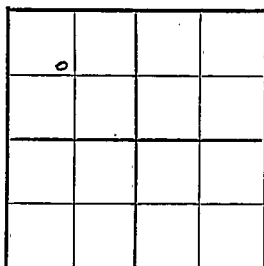Nunn Pool

Location

Rig up

Drilling and Remarks:

Lease 3860
Sand #608.5" C 4712Prof. Sand & Lease9300 ac. & CPump 10 Ps &.36 C & L

RECORD

Cased _____ in., _____ ft.

Sand _____

Gas _____

Oil _____

Total Depth 4791

PRODUCTION

1st 24 hrs. Nat. _____

1st 24 hrs. after shot _____

Gas _____ Cu. Ft.

Dry Hole _____

Abandoned _____

Date

JAN 12 1944

19

S. J. LEWIS Scout