


TOPOGRAPHIC ENGINEERING COMPANY
Surveying and Mapping for the Oil & Gas Industry

409 Regency Tower 333 N.W. 5th St. (405) 235-2363
Oklahoma City, Okla. 73102

22-21-36W

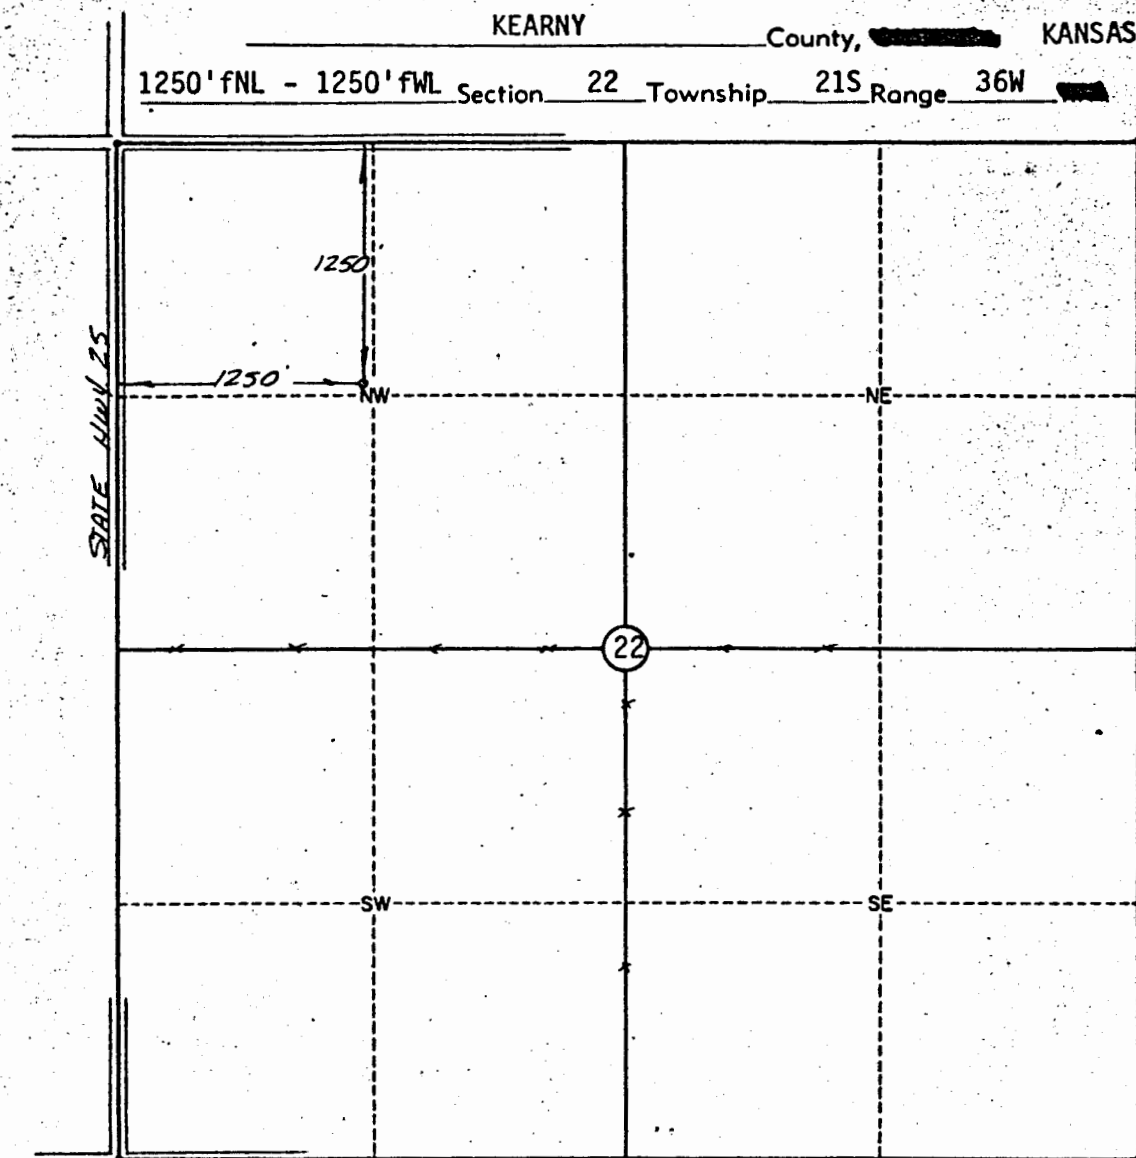

Scale: 1" = 1000'

Date Staked: January 8, 1976

This location has been very carefully staked on the ground according to the best official survey records, maps, and photographs available to us, but its accuracy is not guaranteed.

Review this plat and notify us immediately of any possible discrepancy.

Operator: CIMARRON EXPLORATION COMPANY

ELEVATION:

3231' Gr.

Lease Name: Well No.:

Topography & Vegetation level cultivated field

Good Drill Site? yes Reference Stakes or Alternate Location Stakes Set none

Best Accessibility to Location from West

Distance & Direction from Hwy Jct or Town from Lakin, go 19 miles North on SH 25 to the

NW corner Sec. 22-21S-36W.