

Stafford

KANSAS

Section 36 Township 21 Range 12WWell No. #1 MelliesCompany Iron Drlg.

NORTH

							0

WEST

EAST

SOUTH

Stafford KANSAS

Sec. 36 Twp. 21 R. 12W ✓

Well No. #1 Mellies Farm

Iron Drlg. Company

Iron Drlg. - Contr. Contractor

Duggan Pool


330' Ft. from N. Line

_____ Ft. from S. Line

330' Ft. from E. Line

_____ Ft. from W. Line

NE NE NE

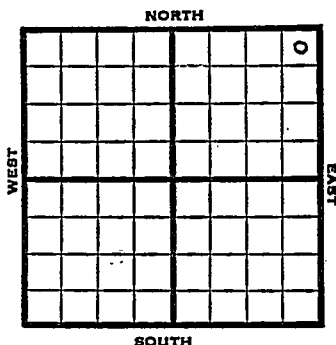

1951

Elev. 1794' REPORT

4/25

Spud 4-22-51

8" @ 280

WOC

5/23

Spud 4-22-51

D&A TD 3606

8" @ 280 Lans. 3206

Arb. 3555 Cong. 3500

Simp 3510 TD 3606

DST 3559-57 opn 30 min.

Rec. 25' mud

DST 3569-3606 opn 1/2 hr. Rec. 25' mud

D&A

ABANDONED

County **Stafford** State **Kansas**
 Sec. **36** (Blk.) **21** (Sur.) **12W** Map No.

Operator **Iron Drlg.**
 Well No. **1** Farm **Mellies**

Elev. Location **NE NE NE**

330 Ft. From **N** Line **NE**

330 Ft. From **E** Line Quarter

1st. Report **APR 25 1951**

Completion

Remarks

Iron Drlg. - Contr.


Spudding Date **4-22-51**

Drlg. Data **Duggan Pool**

8" @ 280 WOC

J. E. TYRA

County Stafford State Kansas
 Sec. 36 (Blk.) 21 (Sur.) 12W Map No.
 Operator Iron Drlg.
 Well No. 1 Farm Mellies
 Elev. 1794 Location NE NE NE

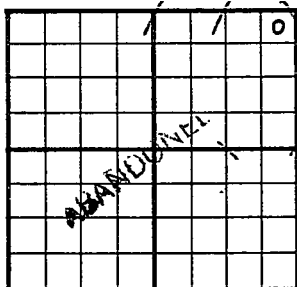

330 Ft. From N Line NE
330 Ft. From E Line Quarter

1st. Report

Completion MAY 23 1951

Remarks Duggan Pool

Iron Drlg. - Contr.

Spudding Date 4-22-51

Drlg. Data D & A TD 3606

8" @ 280 Lans. 3206 Arb. 3555

Cong. 3500 Simp. 3510 TD 3606

DST 3559-67 open 30 min. Rec. 25' mud

DST 3569-3606 open 1 hr. Rec. 25' mud

D & A

J. E. TYRA