

KANSAS

Stafford


Form 51-5M-7-39-Palace

Section 36 Township 21 Range 12-W

Well No. #2 Mellies "A"

Company Trigg & Allen

NORTH **Sittner Pool**

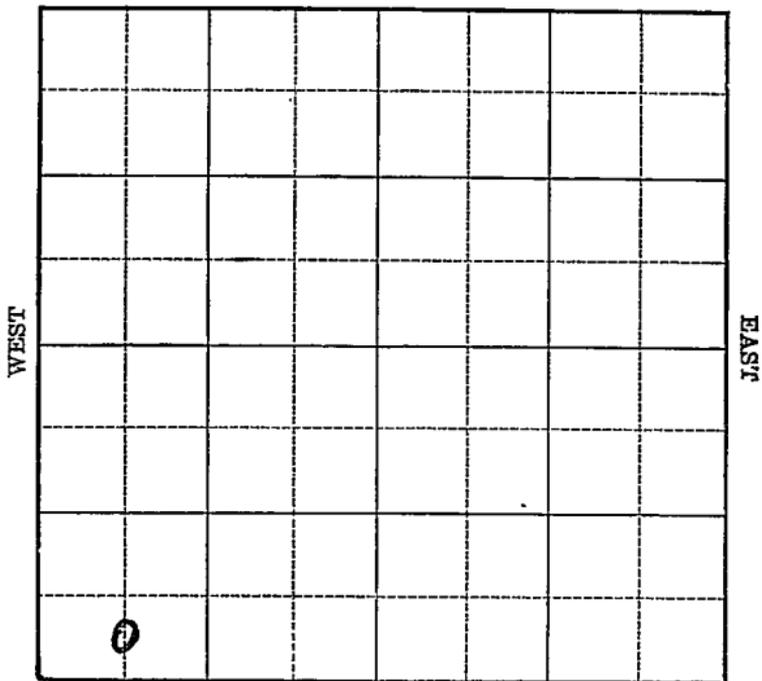

SOUTH

Sec. 36 Twp. 21 R. 12-W

Well No. #2 Mellies "A" Farm

Trigg & Allen Company
(Sittner)


_____ Ft. from N. Line

330 Ft. from S. Line

_____ Ft. from E. Line

660 Ft. from W. Line

Elev. 1812

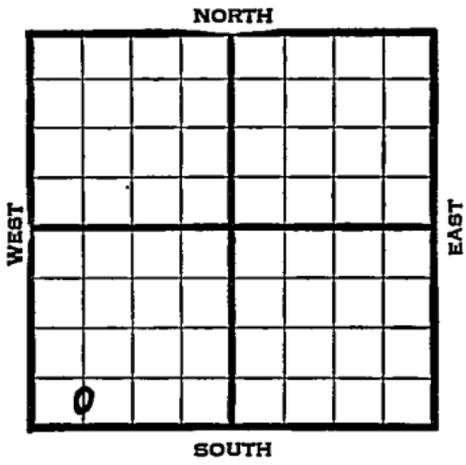

1940	REPORT
5/8	Bldg. Derrick.
5/16	10" - 174' Anhy 570'
	Drlg. 1510'
5/23	Drlg. 3132'
5/29	Lans. 3224' Viola 3483'
	Arb. 3565' T.D. 3566'
	5" - 3565' RUST.
6/5	Arb. 3565'
	5" - 3565'
	T.D. 3574'
	2000 acid.
	Potential 65 bbls., pump.
	COMPLETED

Map No. 46 Sec. 36 Twp. 21 R. 12WWell No. 2 Mellies "A"Trigg & Allen Company

Contractor

FIRST REPORTC $S\frac{1}{2}$ SW SW

_____ Ft. from N. Line

330 Ft. from S. Line

_____ Ft. from E. Line

660 Ft. from W. Line**SITTNER POOL****SECTION PLAT**

Location _____

Rig up _____

Drilling and Remarks:

Bldg. Derrick**RECORD**

Cased _____ in., _____ ft.

Sand _____

Gas _____

Oil _____

Total Depth _____

PRODUCTION

1st 24 hrs. Nat. _____

1st 24 hrs. after shot _____

Gas _____ Cu. Ft.

Dry Hole _____

Abandoned _____

Date

MAY 8 1940 19**S. J. LEWIS**

Scout

Map No. 46 Sec. 36 Twp. 21 R. 12W

Well No. 2 Mellies "A"

Trigg & Allen Company

Contractor

COMPLETED

SECTION PLAT

0 S $\frac{1}{2}$ SW SW

 Ft. from N. Line

330 Ft. from S. Line

 Ft. from E. Line

660 Ft. from W. Line

SITTNER POOL

Location

Rig up

Drilling and Remarks:

Cr & 3565
5" @ 3565
2000 acid
Pump 65 P.D.

RECORD

Cased in., ft.

Sand

Gas

Oil

Total Depth 3574

PRODUCTION

1st 24 hrs. Nat.

1st 24 hrs. after shot

Gas Cu. Ft.

Dry Hole

Abandoned

Date

JUN 5 1940 19

S. J. LEWIS Scout