

Section 36 Township 21 Range 12WWell No. #2 Mellies "B"Company petroleum, Inc.

Max Pool

NORTH

WEST

EAST

					0		

SOUTH

Stafford **KANSAS**
12W

Sec. 36 Twp. 21 R. 12W

Well No. #2 - Mellies "B" Farm

Petroleum, Inc. Company


Max Pool (Ferrell Drlg., Conn.)

 Ft. from N. Line

330' Ft. from S. Line

 Ft. from E. Line

990' Ft. from W. Line

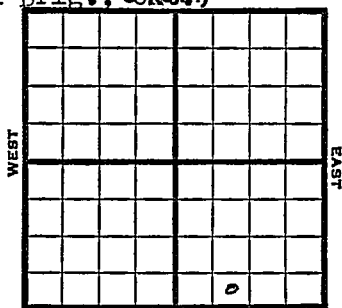

SE SW SE

SOUTH

1949 Elev. 1810' REPORT

12/14 8" @ 244'
Anhy 565'
Drlg. 1350'

12/21 Lansing 3220'
Drlg 3348'

12/28 Arb. 3567'-69'
TD 3569'
5" @ 3568'

1950

1/25 8" @ 244' Arb 3567'
5" @ 3568' Simp 3524'
P 168 BOPD Lans 3214'
TD 3569' Br. L 3205'

COMPLETED

Kansas

Map No. _____ Sec. 36 Twp. 21 R. 12WWell No. 2 Mellies "B"_____
Petroleum Inc. _____ Company_____
Ferrell Drlg. _____ Contractor

SE SW SE

FIRST REPORT
SECTION PLAT_____
Ft. from N. Line_____
330 Ft. from S. Line_____
Ft. from E. Line_____
990 Ft. from W. Line

Stafford County

Location _____

Rig up _____

Drilling and Remarks: .

8" @ 2 44Anhy 565drlg. 1350

RECORD

Cased _____ in., _____ ft.

Sand _____

Gas _____

Oil _____

Total Depth _____

PRODUCTION

1st 24 hrs. Nat. _____

1st 24 hrs. after shot. _____

Gas _____ Cu. Ft.

Dry Hole _____

Abandoned _____

Date

DEC 14 1949 19S. J. LEWIS Scout

Scout Cards	2
Land Small Map	1
Land Wall Map	3
Tracings	
Finance M	
Pi re li	
Misc	

DEC 16 1949

Kansas

Max Pool

Map No. _____ Sec. 36 Twp. 21 R. 12WWell No. 2 Mellies "B"_____
Petroleum Inc. _____ Company_____
Contractor

SE SW SE

E1. 1810
SECTION PLAT

COMPLETE			

Ft. from N. Line330 Ft. from S. Line_____
Ft. from E. Line990 Ft. from W. Line_____
Stafford County

RECORD

Location _____

Cased _____ in., _____ ft.

Rig up _____

Sand _____

Drilling and Remarks:

Gas _____

Oil _____

Total Depth 35698" @ 2445" @ 3568P 168 BOPDC

PRODUCTION

1st 24 hrs. Nat. _____

1st 24 hrs. after shot _____

Gas _____ Cu. Ft.

Dry Hole _____

Abandoned _____

Date

JAN 25 195019J. E. TYRA Scout

Br L 3205

Lans 3214

Simp 3524

Ant 3567

Scout Cards	
Land Small Map	
Land Wall Map	
Tracings	
France Map	
Pierre Map	
Misc	

JAN 30 1950