
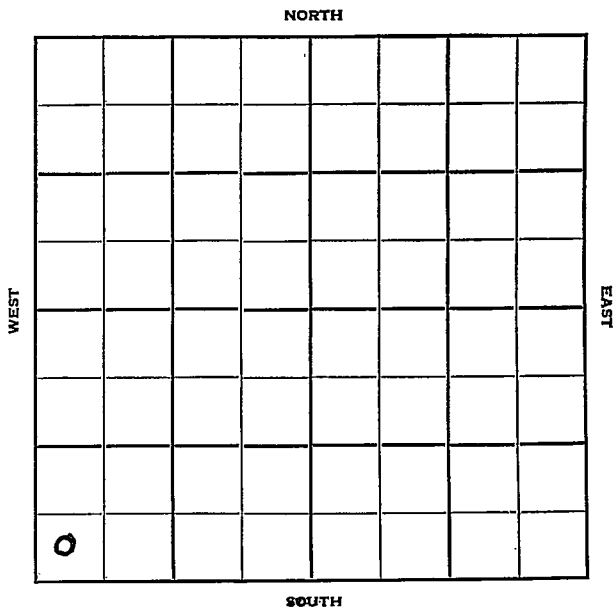


Section 36 Township 21 Range 13 WWell No. # 1 FischerCompany Elreco

Sec. 36 Twp. 21 R. 13WWell No. #1 Fischer FarmElreco CompanyAnschutz Contractor Ft. from N. Line330 Ft. from S. Line Ft. from E. Line330 Ft. from W. Line

SW SW SW

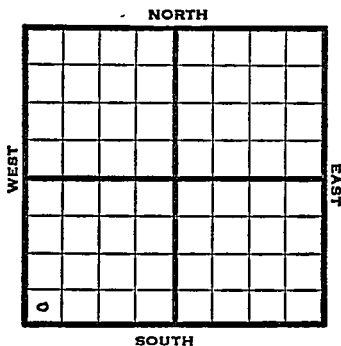

1952

Elev. 1878' REPORT

9/4

MIM

9/10

8" @ 324 Drlg. 1029

9/17

Heeb. 3186' Br Li 3316

Lans. 3332

DST 3412-19, 1 hr. 10' m

Cong. 3577'

Drlg. 3633'

9/24

Spud 9-6-52

D&A TD 3737

8" @ 324 Heeb. 3186

Br Lime 3316 Lans. 3332

DST 3412-19 opn 1 hr. Rec. 10' mud

O# Cong 3577 TD 3737

D&A

ABANDONED

County Stafford State KansasSec. 36 (Blk. 21 (Sur. 13W Map No.Operator ElrecoWell No. 1 Farm FischerElev. Location SW SW SW

0									

330 Ft. From S Line SW330 Ft. From W Line Quarter1st. Report SEP 4 1952

Completion

Remarks

Anschutz - Contr.

Spudding Date

Drig. Data

M I M

