


KANSAS, Stafford

Section 36 Township 21 Range 13W

Well No. 1 Fischer

Company Glenn Peel *Made by J. E. Gussman*

Wildcat
NORTH

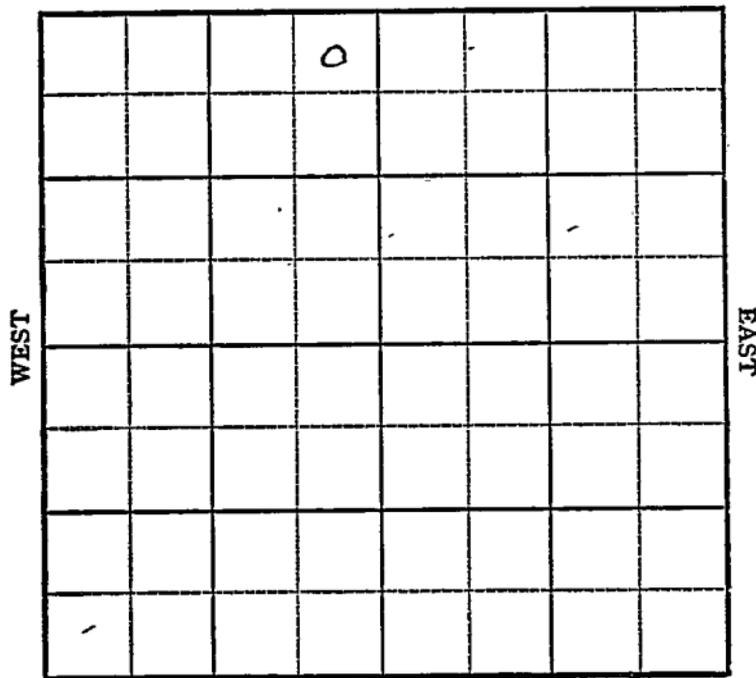

SOUTH



Sec. 36 Twp. 21 R. 13W

Well No. #1 Fischer Farm

~~Glen Pool~~ Nadel & Gussman Company

Wildcat


330' Ft. from N. Line

_____ Ft. from S. Line

330' Ft. from E. Line

_____ Ft. from W. Line

NE NW

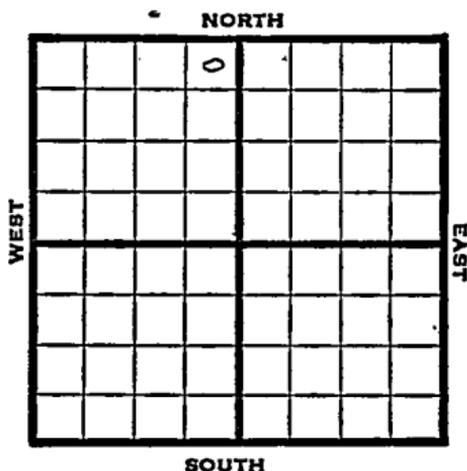

1948 Elev. 1878' REPORT

8/18 Location

8/25 8" @ 290'
Drlg 2300'

9/1 Arbuckle 3633'
TD 3637'
5" @ 3635'

9/7 Top Arbuckle 3637 (Corrected)
Total Depth 3641
5" casing set 3639 (Corrected)
Drilled cement and deepened to Total
depth of 3642
Filled up 3200 feet oil over night
Swabbed 10 to 12 barrels oil per hour
Natural. To Acidize

9/8 SLM 3637=41
Arbuckle 3637'
5" @ 3639'
TD 3642'
Swb 12 oil PH-4 hrs.

9/14 1000 acid
Swb 100 bbls oil 1 hr.

9/21 "

OVER

1948

9/29 Arbuckle 3637'
5" @ 3639'
1000 acid
Echo Pot. 3000 oil
Gr. 39°
TD 3642'

COMPLETED

Stafford County Kansas State

Map No. _____ Sec. 36 Twp. 21 R. 13W

Well No. 1 Fischer

Glen Peel Company

FIRST REPORT

Contractor

NE NW

SECTION PLAT

330 Ft. from N. Line

_____ Ft. from S. Line

330 Ft. from E. Line

_____ Ft. from W. Line

Wildcat

Remarks:

Location



Date
AUG 18 1948

Scout
S. J. LEWIS

TRANSFER

- Misc. Small Maps
- Cards _____
- Tracing _____
- France Map _____
- Scarborough Map _____
- Pierce Map _____
- Geological Dept. _____
- Pierce Plat Book _____

Stafford County Kansas State

Map No. 82 Sec. 36 Twp. 21 R. 13W

Well No. 1 Fischer

Nadel & Gussman Company

CORRECTION Contractor

NE NW

SECTION PLAT

330 Ft. from N. Line

 Ft. from S. Line

330 Ft. from E. Line

 Ft. from W. Line

		0			


Wildcat

Remarks:

Reported Glen Peel

Date
AUG 25 1948

Scout
S. J. LEWIS

 


- Misc. Small Maps _____
- Cards _____
- Tracing _____
- France Map _____
- Scarborough Map _____
- Pierce Map _____
- Geological Dept. _____
- Pierce Plat Book _____

Map No. 82 Sec. 36 Twp. 21 R. 13W

Well No. 1 Fischer

Nadel & Gussman Company

COMPLETE Contractor

NE NW

~~E 11 87 8~~
SECTION PLAT

330 Ft. from N. Line

_____ Ft. from S. Line

330 Ft. from E. Line

_____ Ft. from W. Line

	4		

Stafford County

Location _____

Rig up _____

Drilling and Remarks:

Cor Y 3639
5" 03639.
1000 Gall
Echo Po Y.
3000 gal
89°/hr

RECORD

Cased _____ in., _____ ft.

Sand _____

Gas _____

Oil _____

Total Depth 3642

PRODUCTION

1st 24 hrs. Nat. _____

1st 24 hrs. after shot _____

Gas _____ Cu. Ft.

Dry Hole _____

Abandoned _____

Date

SEP 29 1948 19 S. J. LEWIS Scout

what is potential

Misc. Small Maps	_____
Cards	_____
Tracing	_____
France Map	_____
Scarborough Map	_____
Pierce Map	_____
Geological Dept.	_____
Pierce Flat Book	_____