


Section 36 Township 21 Range 13-W

Well No. 1 Fischer Heirs

Company Magnolia

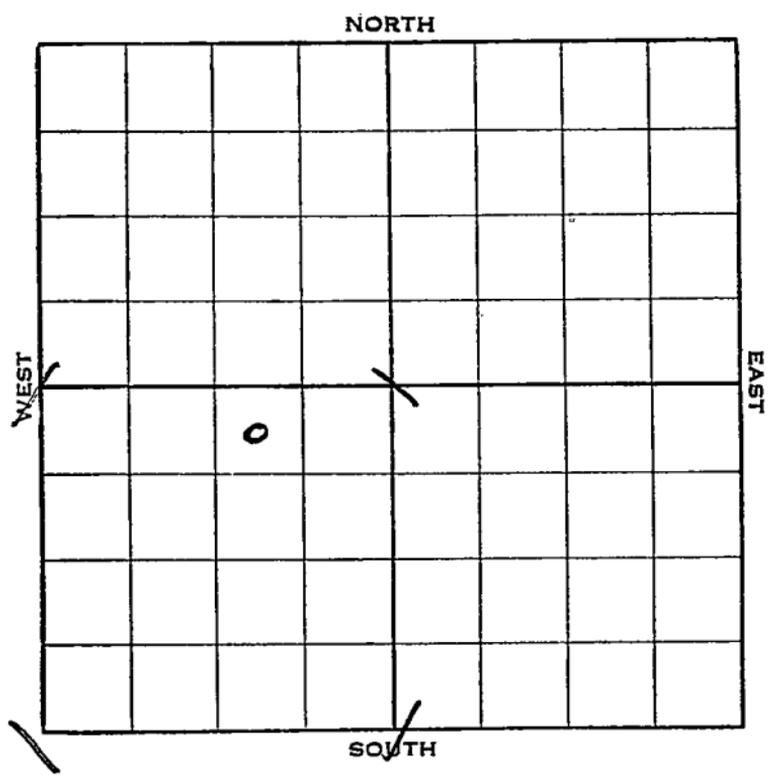

Sec. 36 Twp. 21 R. 13-W

Well No. #1 Fischer Heirs Farm
Magnolia Company


330 Ft. from N. Line

_____ Ft. from S. Line

990 Ft. from E. Line

_____ Ft. from W. Line

Elev. 1878

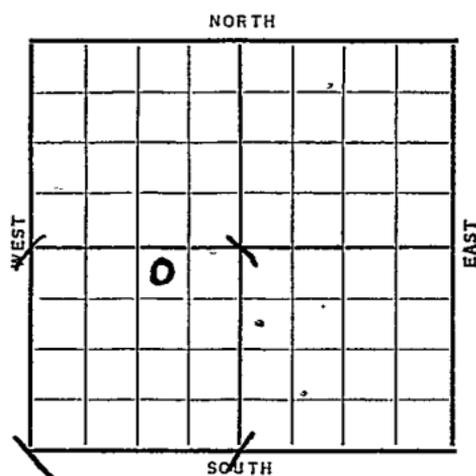

Date	REPORT
1938	
7/13	R U R .
7/22	13" - 260'. Dlg. 2194'.
7/29	Drlg. 3455'.
8/5	Tonoka 2910'. Lans. 3352'.
	Viola 3672'. Simp. 3725'.
	Arb. 3757'. T.D. 3766'.
	Good Sat. 7" - 3757'. RUST.
8/12	3766 equals 3769'.
	Arb. 3748'. (Corrected)
	7" - 3757'. RUST.
8/19	1000 acid.
	Shot 15 qts. 3764-69'.
	Bailed 1 oil & 2 water in 7 hrs.
8/26	Dlg. 3777'.
9/2	H. F. W. 3874-77'.
	P. B. 3790'. WOC.
9/9	" " "
9/16	P. B. 3783'. 2000 acid.
	S. O. & W.

OVER

1938

9/21

7" at 3757'.

Arb. 3748'.

~~T.D. 3777' H.F.W.~~

T.D. 3877 HFW

P.B. 3783

3000 acid

D & A

ABANDONED

Stafford KANSAS

Map No. 82 Sec. 36 Twp. 21 R. 13W

Well No. 1 Fischer Heirs

Magnolia Company

Contractor

FIRST REPORT

NW NE SW


330 Ft. from N. Line

_____ Ft. from S. Line

990 Ft. from E. Line

_____ Ft. from W. Line

SECTION PLAT

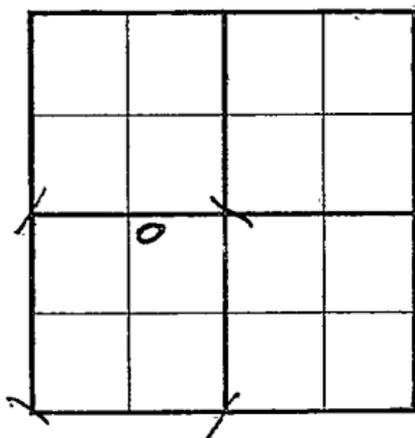

Location _____

Rig up _____

Drilling and Remarks:

RUR

RECORD

Cased _____ in., _____ ft.

Sand _____

Gas _____

Oil _____

Total Depth _____

PRODUCTION

1st 24 hrs. Nat. _____

1st 24 hrs. after shot _____

Gas _____ Cu. Ft.

Dry Hole _____

Abandoned _____

Date


JUL 13 1938 19

H. D. Hatfield Scout

27000000

100000000

TALK CONTROL

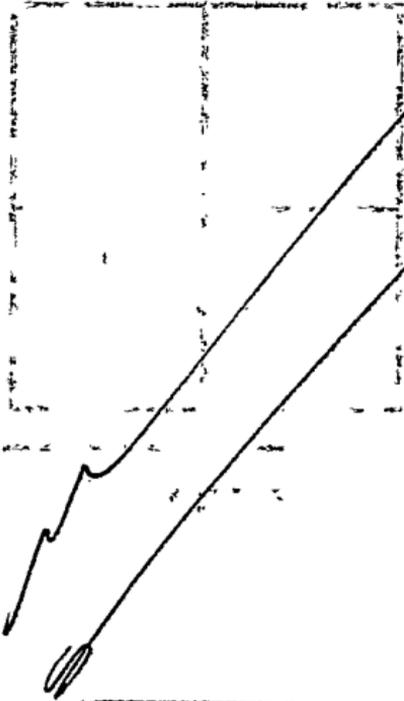

RM

Returned	
Cards	<i>Paul</i>
Tracing	<i>Jim</i>
France Map	<i>RM</i>
Scarborough Map	<i>RM</i>
Moody Map	<i>RM</i>
Scarborough Plat Book	
Moody Plat Book	

Stafford **KANSAS**

Map No. 82 Sec. 36 Twp. 21 R. 13W

Well No. 1 Fischer Heirs

Magnolia

Company

Contractor

SECTION PLAT

NW NE SW

330 Ft. from N. Line

Ft. from S. Line

990 Ft. from E. Line

Ft. from W. Line

	0		

Location _____

Rig up _____

Drilling and Remarks:

300 acid

DVA

RECORD

Cased 7 in., 3757 ft.

Sand Arb 3748

Gas _____

Oil 3877 HFW

Total Depth ~~3777~~ PB

PRODUCTION 3783

1st 24 hrs. Nat. _____

1st 24 hrs. after shot _____

Gas _____ Cu. Ft.

Dry Hole _____

Abandoned _____

Date

Check T. D. and Plugged back record.

Paul.

OK now

Ray

Returned	<i>Ray</i>
Cards	<i>Ray</i>
Tracing	<i>Ray</i>
Finance Map	<i>Ray</i>
Spec on U Map	<i>Ray</i>
Moody Map	
Scarbrough Hist Book	
Moody Plot Book	

