

KANSASSection 36 Township 21 Range 13WWell No. 1 Fischer Est.Company Pickrell DrlgFischer
NORTH

WEST

EAST

SOUTH

KANSAS

Stafford

Sec. 36 Twp. 21 R. 13W

Well No. #1 Fischer Est. Farm

Pickrell Drlg. Company


Fischer Pool

 Ft. from N. Line

330' Ft. from S. Line

330' Ft. from E. Line

 Ft. from W. Line

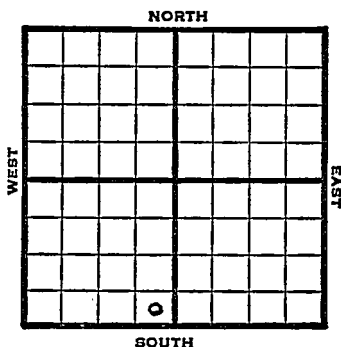

SE SW

1949 Elev. 1878' REPORT

3/9 8" @ 290'
Anhy. 775'
Drlg. 2609'
3/16 Lansing 3325'
Simp 3628'
TD 3687'
5" @ 3685'
3/22 Drlg 3695'
SSO
3/30 Lang 3325'
Viola 3589'
Simp 3628'
Arb. 3684'
5" @ 3685'
TD 3719'

Viola 3589'
Arbuckle 3684'

ABANDONED

Map No. _____ Sec. 36 Twp. 21 R. 13W

Well No. 1 Fischer Est.

Pickrell Drlg. Company _____

FIRST REPORT Contractor _____

SE SW


SECTION PLAT

_____ Ft. from N. Line

330 Ft. from S. Line

330 Ft. from E. Line

_____ Ft. from W. Line

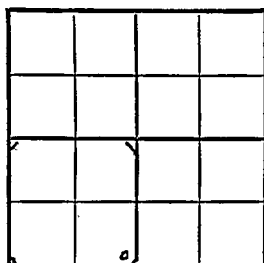

Stafford County

RECORD

Location _____

Rig up _____

Drilling and Remarks:

8" @ 290

Anhy 775

drlg. 2609

Cased _____ in., _____ ft.

Sand _____

Gas _____

Oil _____

Total Depth _____

PRODUCTION

1st 24 hrs. Nat. _____

1st 24 hrs. after shot _____

Gas _____ Cu. Ft.

Dry Hole _____

Abandoned _____

Date

MAR 9 1949 19

S. J. LEWIS Scout

Kansas

13W


Map No. 82 Sec. 36 Twp. 21 R. Well No. 1 Fischer Est.Pickrell Drlg.

Company

ABANDONED

Contractor

SE SW

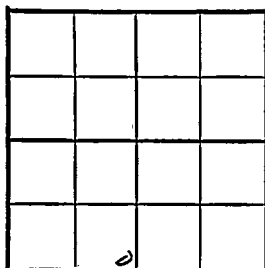E 1, 1878
SECTION PLAT Ft. from N. Line330 Ft. from S. Line330 Ft. from E. Line Ft. from W. Line

Stafford County

Location Rig up

Drilling and Remarks:

*Line 325**12 to 3589**Line 3625**Cr 3654**5" C 3655*

RECORD

Cased in., ft.Sand Gas Oil Total Depth 3719

PRODUCTION

1st 24 hrs. Nat. 1st 24 hrs. after shot Gas Cu. Ft.Dry Hole Abandoned

Date

MAR 30 1949 19

S. J. LEWIS

Scout