


Section 36 Township 21 Range 13 W

Well No. # 2 Fischer Est.

Company Anschutz Drlg.

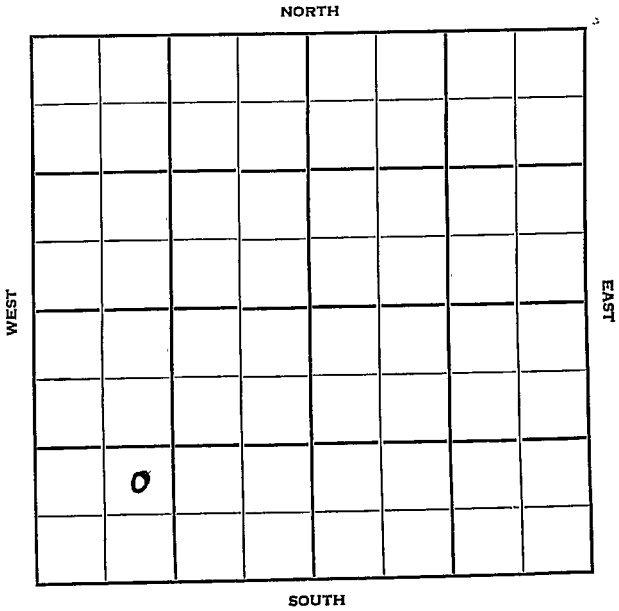

Sec. 36 Twp. 21 R. 13W

Well No. #2 Fischer Est. Farm _____

Anschutz Drlg. Company _____

Anschutz Contractor _____


_____ Ft. from N. Line

990 Ft. from S. Line

_____ Ft. from E. Line

990 Ft. from W. Line

NE SW SW

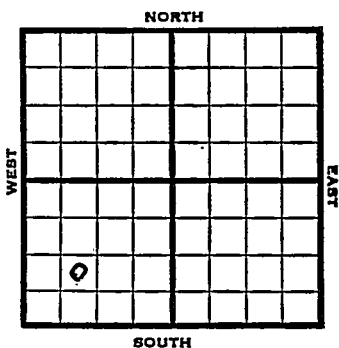

1953

REPORT

Elev. 1877'

4/15

Spud 4-10-53
8" @ 253
Anhy 700
Drlg. 1800'

4/23

Heeb 3185' Tor 3204' Br li 3311'
Lans 3329'
DST 3348-99, 1 hr, 95' SW, 1040#
B KC 3558' Cong. 3587' Arb. 3682'

4/30

TD 3710' 5" @ 3709'
CO 3706 45/3685-93 NS 1000 A
Lost load. 36/3674-79 1 1/2 GO & 8 GW
A-frac.

5/7

S/1-3/4 Bfph mostly w.

5/21

NR

5/28

"

6/3

Spud 4-10-53 D & A TD 3710
8" @ 253 Anhy 700 Heeb 3185
Tor. 3204 Br lime 3311 Lans 3329
DST 3348-99 open 1 hr rec 95' SW
1040# B KC 3558 Cong 3587
Arb. 3682 TD 3710 5" @ 3709
CO to 3706 45/3685-93 1000 A
36/3674-79 1 1/2 GO 8 GW A-frac.
S/1-3/4 BFPH mostly wtr.
D & A

ABANDONED

