


Section 36 Township 21 Range 13W

Well No. #3 Fischer

Company Nadel & Gussman

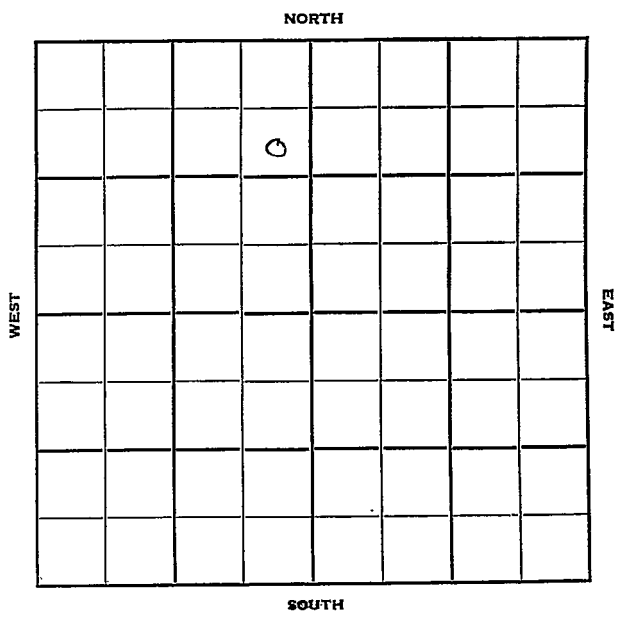

Stafford

KANSAS

Sec. 36 Twp. 21 R. 13W

Well No. #3 Fischer Farm

Nadel & Gussman Company

Reserve Contractor

Fischer NW

NORTH


990 Ft. from N. Line

Ft. from S. Line

Ft. from E. Line

330 Ft. from W. Line

SE NE NW

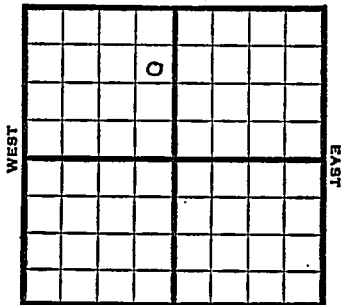

1952

Elev. 1882' REPORT

3/5 Location

3/12 8" @ 330
Anhy 710
Drlg. 2031'

3/19 Spud 3-7-52
D&A TD 3800
8" @ 330
Anhy 710 Heeb. 3178
Br lime 3310 Lans. 3326
Cong. 3269-3800 TD
D&A

ABANDONED

County Stafford State Kansas

Sec. 36 (Blk. Twp.) 21 (Sur. Rge.) 13W Map No.

Operator Nadel & Gussman

Well No. 3 Farm Fischer

Elev. 1882 Location SE NE NW

		D			

990 Ft. From N Line NW

330 Ft. From E Line Quarter

1st. Report MAR 19 1952

Completion

Remarks NW Fischer Pool

Reserve Drlg. - Contr.

Spudding Date 3-7-52

Drlg. Data D & A TD 3800

8" @ 330 Anhy 710 Heeb. 3178

Br. lime 3310 Lans. 3326 Cong. 3569-3800 TD

D & A

J. G. McGEHEE