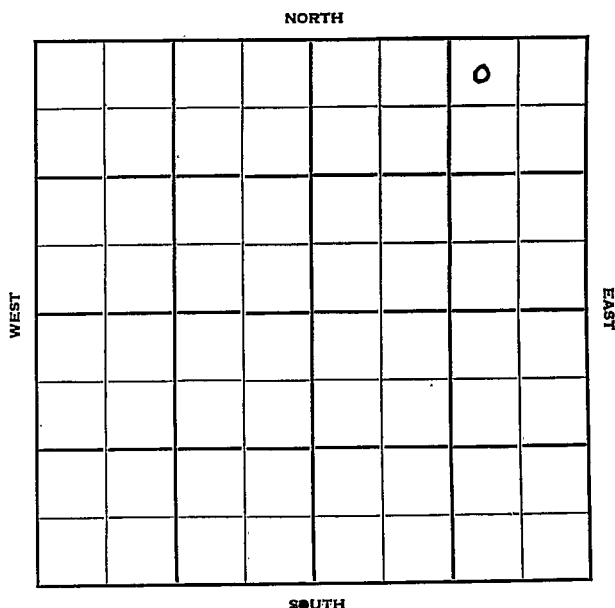


Section 36 Township 21 Range 13 WWell No. # 1 Fischer (C)Company Nadel & Gussman

Stafford


KANSAS

Sec. 36 Twp. 21 R. 13 WWell No. # 4 Fischer (C) FarmNadel & Gussman CompanyReserve Contractor

Fischer NW

330 Ft. from N. Line Ft. from S. Line990 Ft. from E. Line Ft. from W. Line

NW NE NE

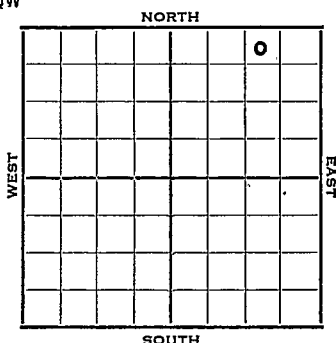

1952 Elev. 1879' REPORT

2/27 Spud 2-23-52
8" @ 330'
Anhy 602'
Drlg. 845'

3/5 Heeb. 3148 Lans. 3293
DST 3414-44 20 mins
Est 1444 gas 480' GCM
V. 3532
Drlg. 3582'

3/12 Simp Sh 3568 Arb. 3620-23
RTD
5" @ 3622' WOG

3/19 DP

3/25 NR

4/1 500 A fill up 3300' oil

4/9 Spud 2-23-52
Oil well TD 3623' 8" @ 330
Anhy 602' Heeb 3148' Lans. 3292'
DST 3414-44 open 20 min, Est 1 M gas
480' gas CM Viola 3532' Simp 3568'
Arb. 3620' 5" @ 3621' TD 3623'
500 A FU 3300' oil, 1000 A
Comp. 3000 BOPD

COMPLETED

County Stafford State KansasSec. 36 (Blk. Twp.) 21 (Sur. Rge.) 13W Map No.Operator Nadel & GussmanWell No. 4 Farm Fischer (C)Elev. Location NW NE NE

FIRST REPORT

330 Ft. From N Line NE990 Ft. From E Line Quarter1st. Report FEB 27 1952

Completion

Remarks

Reserve - Contr.Spudding Date 2-23-52Drlg. Data Fischer NW8" @ 330 Anhy 602 Drlg. 845J. G. McGEHEE

County Stafford State Kansas
 Sec. 36 (Blk. 21) (Sur. 13W) Map No.

Operator Nadel & Gussman

Well No. 4 Farm Fischer "C"

Elev. 1879 Location NW NE NE

330 Ft. From N Line NE

990 Ft. From E Line Quarter

1st. Report

Completion APR 9 1952

Remarks NW Fischer Pool

Reserve Drlg. - Contr.

Spudding Date 2-23-52

Drlg. Data Oil well TD 3623

8" @ 330 Anhy 602 Heeb. 3148

Lans. 3293 DST 3414-44 open 20 min.

est 1 M gas 480' gascm Viola 3532

Simp. 3568 Arb. 3620 5" @ 3621

TD 3623 500 A FU 3300' oil 1000 A

Comp. 3000 bopd