


Section 36 Township 21 Range 11W

Well No. 1 Curtis

Company Barbara Oil

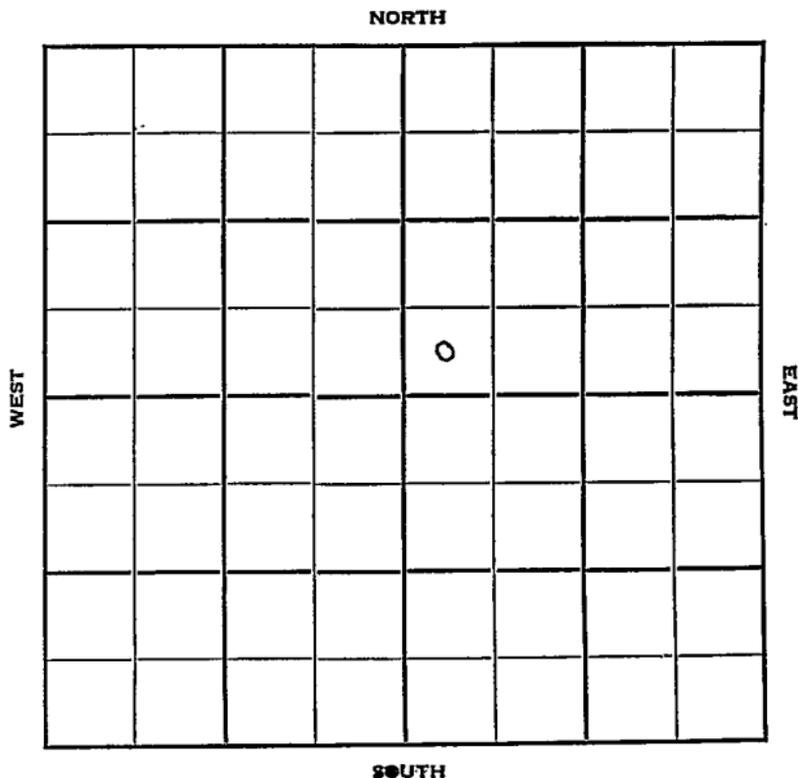

Stafford KANON

Sec. 36 Twp. 21 R. 14W

Well No. #1 Curtis Farm

Barbara Oil Company

Garvey Oil - Contr. Contractor

Wildcat


Ft. from N. Line

330' Ft. from S. Line

Ft. from E. Line

330' Ft. from W. Line

SW SW NE

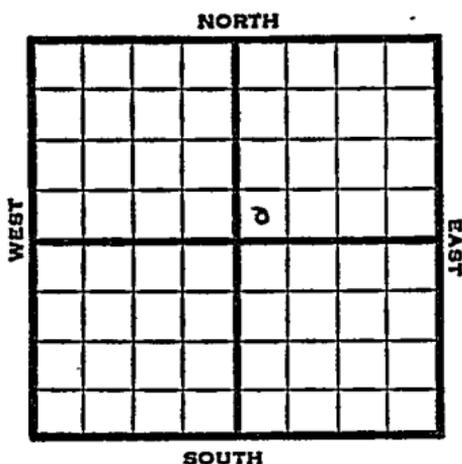

1951 Elv. 1925' REPORT

8/1 Spud 7-23-51
8" @ 203
Anhy 820
Heeb. 3248
Lans. 3419
Drlg. 3516'

8/8 Spud 7-23-51
D & A TD 3830'
8" @ 203' Anhy 820' Heeb 3248'
Lans. 3419' Cong 3679' Viola 3705'
Simp. 3757' Arb. 3800-30' TD
D & A

ABANDONED

County Stafford State Kansas

Sec. 36 (Blk. Twp.) 21 (Sur. Rge.) 14W Map No.

Operator Barbara Oil

Well No. 1 Farm Curtis

Elev. 1925 Location SW SW NE

330 Ft. From S Line NE

330 Ft. From W Line Quarter

1st. Report AUG 1 1951

Completion

Remarks Pet. Inc., Stano & Anderson-Fritchard

Garvey Oil - Contr.

Spudding Date 7-23-51

Drig. Data Wildcat

8" @ 203 Anhy 820 Heeb. 3248

Lans. 3419 drlg. 3516

FIRST REPORT


County Stafford State Kansas

Sec. 36 (Blk. 21) (Sur. 14W) (Twp. 21) (Rge. 14W) Map No.

Operator Barbara Oil

Well No. 1 Farm Curtis

Elev. 1925 Location SW SW NE

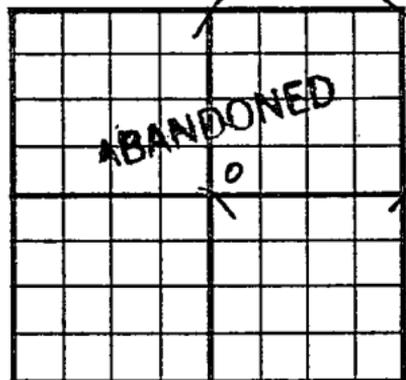

330 Ft. From S Line NE
330 Ft. From W Line Quarter

1st. Report

Completion AUG 8 195

Remarks Wildcat

Garvey Oil - Contr.

Spudding Date 7-23-51

Drilg. Data D & A TD 3830

8" @ 203 Anhy 820 Heeb. 3248

Lans. 3419 Cong. 3679 Viola 3705

Simp. 3757 Arb. 3800-30 TD

D & A