


Section 36 Township 21 Range 14W

Well No. #1 McGinty

Company Welch & Olsson

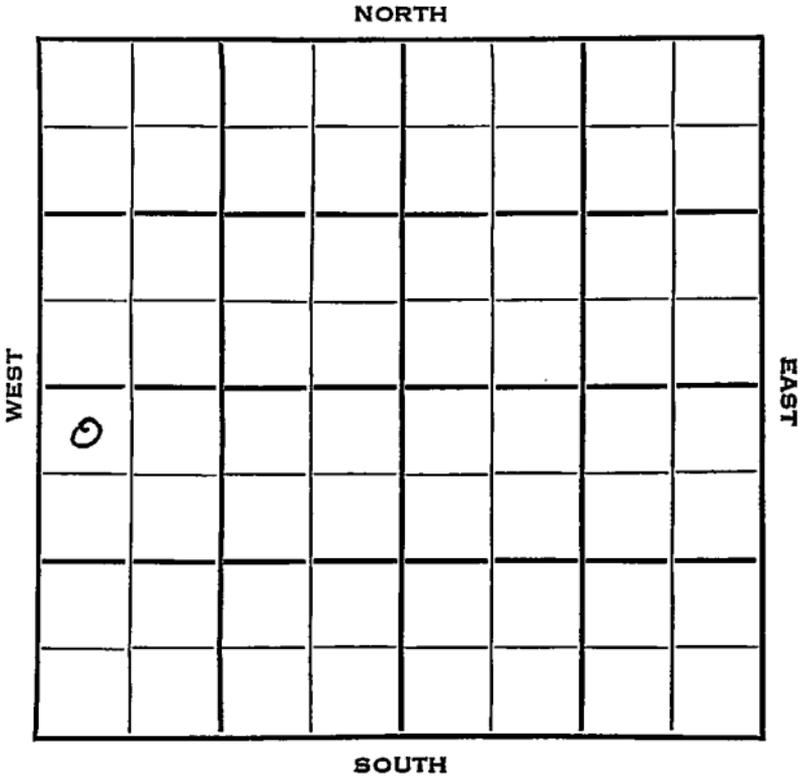

Sec. 36 Twp. 21 R. 14 W

Well No. # 1 McGinty Farm

Welch & Olsson Company

Welch & Olsson Contractor


330 Ft. from N. Line

\_\_\_\_\_ Ft. from S. Line

\_\_\_\_\_ Ft. from E. Line

330 Ft. from W. Line

NW NW SW

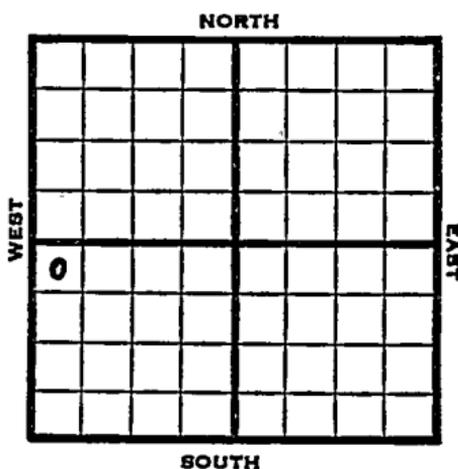

1953

Elev. 1930' REPORT

8/19 MIR

8/26 8" @ 225 Anhy 840'  
Drlg. 3253'

9/2 Spud 8-18-53  
D & A  
TD 3815'  
8" @ 225'  
Anhy 840, Heeb 3287, Tor 3309', Br.  
Lime 3411, Lans 3420, B KC 3642, Cong  
3684, Viola 3687, Simp 3732, Arb 3775  
TD 3815'  
D & A

**ABANDONED**



County Stafford State Kansas

Sec. 36 (Blk. 21) (Sur. 14W) (Twp.) (Rge.) Map No.

Operator Welch & Olsson

Well No. 1 Farm McGinty

Elev. 1930 Location NW NW SW

0					

330 Ft. From N Line SW

330 Ft. From W Line Quarter

1st. Report

Completion SEP 2 1953

Remarks

Welch & Olsson - Contr.

Spudding Date 8-18-53

Drig. Data D & A TD 3815

8" @ 225 Anhy 840 Heeb. 3287

Tor. 3309 Br. lime 3411 Lans. 3420

B KC 3642 Cong. 3684 Viola 3687

Simp. 3732 Arb. 3775 TD 3815

D & A