
FORM 51 25M 8-50 WESTERN **Stafford** KANSAS

Section 36 Township 21 Range 14W

Well No. #1 Keenan "D"

Company Petroleum Inc.

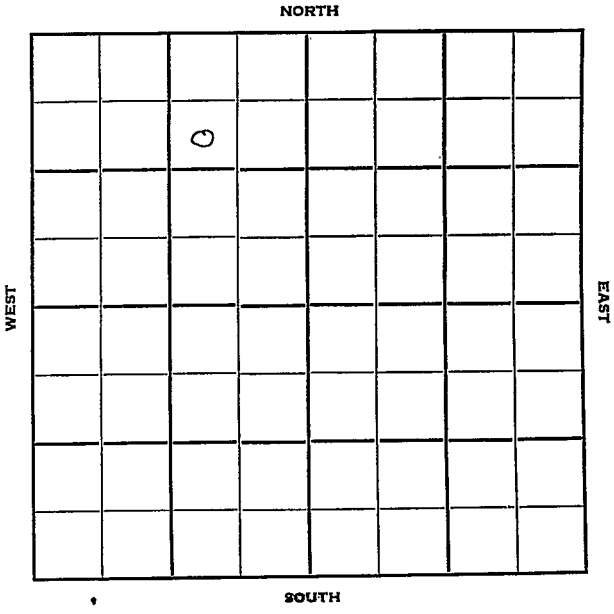

FORM 252-B
10M 8-51 TPCO.

Stafford KANSAS

Sec. 36 Twp. 21 R. 14 W

Well No. # 1 Keenan "D" Farm

Petroleum Inc. Company

Garvey Oil Contractor

Wildcat


990 Ft. from N. Line

Ft. from S. Line

990 Ft. from E. Line

Ft. from W. Line

SW NE NW

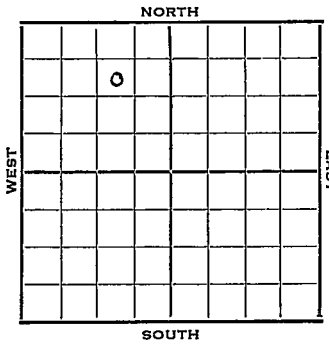

1951	Elev. 1930' REPORT
12/5	Spud 11-28-51 8" @ 200' Drlg. 2425'
1952 1/16	Spud 11-28-51 D & A TD 3826' 8" @ 200 Heeb 3281' Br. lime 3403' Lans. 3413 DST 3443-88, open 1 hr. rec 110' mud & water. DST 3530-45, open 1 hr, rec 25' SOCM DST 3552-82 open 1 hr. rec 80' OCM DST 3591-3601 open 1 hr. rec 90' HOCM Cong. 3674' Viola 3681' DST 3688-3733 open ½ hr. rec 8' mud Simp. 3734' Arb. 3786' TD 3826' 5" @ 3642' 13/3595-99 1½ BOPH 2000 A S/6 BOPH 50% oil 1-3/4 BO 2¼ BWPH PB 3590' 21/3556-66 21/3568-78 S/8 BFPH 70% water. water increased. D & A **ABANDONED**

FORM 275 FOR SALE BY KANSAS BLUE PRINT CO.


County Stafford State Kansas

Sec. 36 (Blk. Twp.) 21 (Sur. Rge.) 14W Map No.

Operator Petroleum Inc.

Well No. 1 Farm Keenan "D"

Elev. Location SW NE NW

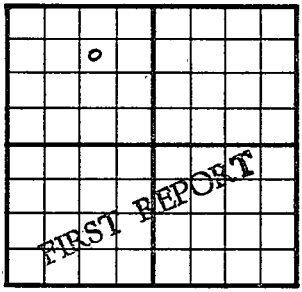

990 Ft. From N Line NW

990 Ft. From E Line Quarter

1st. Report DEC 5 1951

Completion

Remarks Garvey Oil - Contr.

Spudding Date 11-28-51

Drlg. Data Wildcat

8" @ 200 drlg. 2425

J. E. TYRA

FORM 275 FOR SALE BY KANSAS BLUE PRINT CO.


County Stafford State Kansas

Sec. 36 (Blk. Twp.) 21 (Sur. Rge.) 14W Map No.

Operator Petroleum Inc.

Well No. 1 Farm Keenan "D"

Elev. 1930 Location SW NE NW

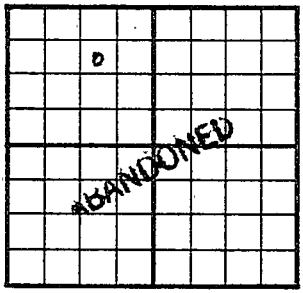

990 Ft. From N Line NW

990 Ft. From E Line Quarter

1st. Report

Completion JAN 16 1952

Remarks Wildcat

Garvey Oil - Contr.

Spudding Date 11-28-51

Drlg. Data D & A TD 3826

8" @ 200 Heeb. 3281 Br. lime 3403

Lans. 3413 DST 3443-88 open 1 hr.

Rec. 110' mud & water DST 3530-45

open 1 hr. Rec. 25' socm DST 3552-82

open 1 hr. Rec. 80' ocm DST 3591-3601

open 1 hr. Rec. 90' hocm Cong. 3674

Viola 3681 DST 3688-3733 open ½ hr.

Rec. 8' mud Simp. 3734 Arb. 3786.

TD 3826 5" @ 3642 13/ 3595-99

1½ boph 2000 A S/ 6 boph 50% oil

1 3/4 bo 2 ¼ bwph PB 3590

21/ 3556-66 21/ 3568-78 S/ 8 bfph

70% water water increased

D & A

J. E. TYRA