



Stafford

KANSAS

14W  
13W

Sec. 36 Twp. 21 R.         

Well No. #2 McGinty Farm         

Pickrell Drlg. Company /         

Pickrell Drlg. Contractor         


Curtis Pool

         Ft. from N. Line

330 Ft. from S. Line

990 Ft. from E. Line

         Ft. from W. Line

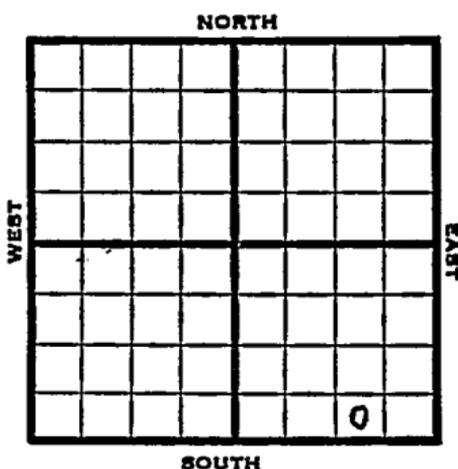

SW SE SE

1953 Elev. 1917' REPORT

8/12 Spud 8-7-53  
8" @ 360  
Anhy 832'  
Drlg. 2241'

8/19 Heeb 3253, Br li 3375, Lans 3387  
DST 3413-25, 1 hr., 540' oil, 920#  
DST 3438-62, 1 hr., 90' o & gcmg  
60' o & gcw, 60' W 600#  
V 3643, Simp 3681, Arb 3729  
RTD 3734  
5" @ 3730'

8/26 DD 3735' 1 BOPH 500 A  
S/17 BOPH 4 hrs. POP

9/2 Spud 8-7-53  
Oil Well  
TD 3735'  
8" @ 360'  
Anhy 832, Heeb 3253, Br. Lime 3375,  
Lans 3387  
DST 3413-25 opn 1 hr, rec 540' oil  
920#  
DST 3438'-62' opn 1 hr, rec 90' o &  
gcm 60' oil & gcw 60' wtr. 600 #  
Viola 3643, Simp 3681, Arb 3729  
TD 3734'  
5" @ 3730'  
DD 3735' 1 boph 500 A S/ 17 boph  
Comp. 50 bopd.

**COMPLETED**



Kansas

Map No. \_\_\_\_\_ Sec. 36 Twp. 21 R. 14WWell No. 2 McGinty

\_\_\_\_\_ Pickrell Drlg. \_\_\_\_\_ Company

**CORRECTION**

\_\_\_\_\_ Contractor

SW SE SE

SECTION PLAT

\_\_\_\_\_ Ft. from N. Line

330 Ft. from S. Line990 Ft. from E. Line

\_\_\_\_\_ Ft. from W. Line

			o

Stafford County

Location \_\_\_\_\_

Rig up \_\_\_\_\_

Drilling and Remarks:

Reported

36-21-13W

## RECORD

Cased \_\_\_\_\_ in., \_\_\_\_\_ ft.

Sand \_\_\_\_\_

Gas \_\_\_\_\_

Oil \_\_\_\_\_

Total Depth \_\_\_\_\_

## PRODUCTION

1st 24 hrs. Nat. \_\_\_\_\_

1st 24 hrs. after shot \_\_\_\_\_

Gas \_\_\_\_\_ Cu. Ft.

Dry Hole \_\_\_\_\_

Abandoned \_\_\_\_\_

Date

AUG 1 9 1953

19

J. G. McGEHEE

Scout

