
Hodgeman KANSAS

SECTION 36 TOWNSHIP 21 RANGE 25W

WELL NO. #1 Hartley

COMPANY Kewanee

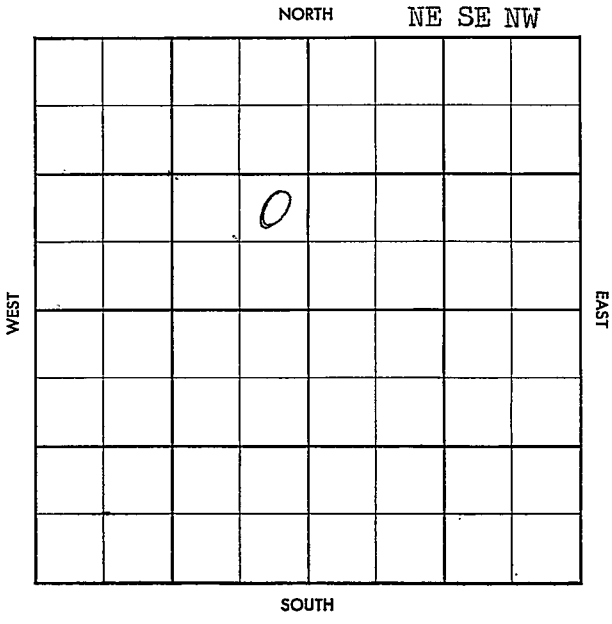

FORM 504-3 SUNRAY

WILDCAT

FORM 513 SUNRAY

County Hodgeman Elev.

Sec. 36 Twp. 21 Rge. 25W

Company Kewanee

Farm Name Hartley No. 1

TOPS	DEPTH	LOG	DATUM
Anh.			
T.P.			
H.			
Tr.			
Dg.			
B.L.			
L.			
K.C.			
B.K.C.			
Ce.			
C.			
M.			
M.			
K.			
Mz.			
Mo.			
V.			
S.			
S.			
A			
R.			
P€.			
G.			
T.D.			

Loc. in Sec. NE SE NW

Geol.

Contr. Graham-Michaelis Tool

Pool Wildcat

RECEIVED JUN 12 '57

FIRST REPORT

e Comm. 6-8-57

" @ 560/320

Co.

Lse.

No.

Sec.

T.

R.

FORM 513 SUNRAY



Company Kewanee

Farm Name Hartley No. 1

TOPS	DEPTH	LOG	DATUM
Anh.			
Tp.			
H.	3866	3867	
Tr.	3884	3880	
Dg. 3902	~~3922~~	3902	
B.L.			
L. 3921	~~3931~~	3916	
K.C.			
B.K.C.	4300		
Ce.			
C. Marm	4322	4323	
M. C9	4534	4532	
M.	4563	4560	
K.			
Mz.			
Mo.			
V.			
S.			
S.			
A			
R.			
Pe.			
G.			
T.D.	~~4652~~ 4652		

Loc. in Sec. 17. SE NW

Geol.

Contr. Wichita Tool

Pool: Wildcat

JUN 26 '57

ABANDONED

Date Comm. - -57

Cable Tools 320 Rotary 4652

DST 3790-3900 DST 4100-4210 DST 4569-92 1hr 835' sulp wtr BHP 1300 145" DST 4569-85 op 1hr 1210' sulp wtr BHP 1350 45"

P & A

Co. Lse. No. Sec. T. R.