


SECTION 36 TOWNSHIP 21 RANGE 34W

WELL NO. #1 Maune

COMPANY Kansas-Nebraska

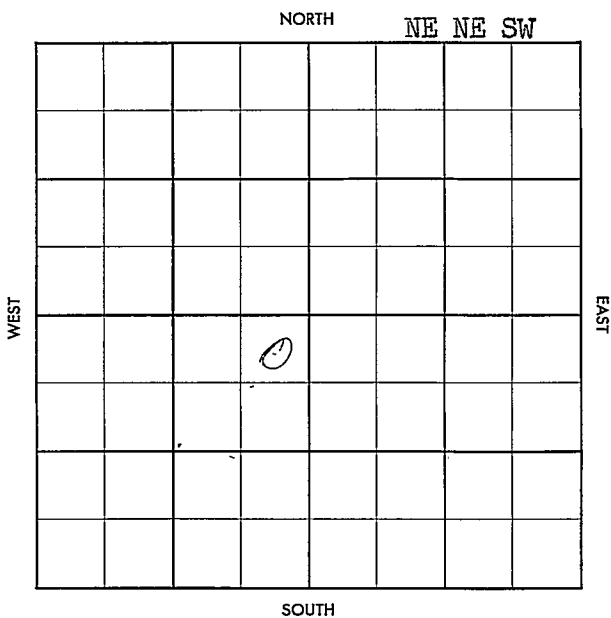

County Finney Elev. _____
 Sec. 36 Twp. 21 Rgs. 31W
 Company Kansas-Nebraska
 FarmName Maine No. 1

TOPS	DEPTH	LOG	DATUM
Anh.			
TP.			
H.			
Tr.			
Dg.			
Bl.			
L.			
K.C.			
B.K.C.			
Ce.			
C.			
M.			
M.			
K.			
Mz.			
Mq.			
V.			
S.			
S.			
A.			
R.			
PC.			
G.			
T.D.			

Loc. in Sec. NE NE SW
150' S & W
of C
 Geol. _____
 Contr. _____
Fees
 Pool _____
Hugoton

FIRST REPORT		
.	.	.
MAY 22 57		

Date Comm. 5-19-57
8" @ 288/200 WOC

3/5

Co. Lse. No. Sec. T. R.

County Finney Elev. 2921
 Sec. 36 Twp. 21 Rge. 31W
 Company Kansas-Nebraska
 Farm Name Maime No. 1

Co.

TOPS	DEPTH	LOG	DATUM	Loc. in Sec.
Anh. <u>Herr</u>		<u>2496</u>		<u>NE NE SW</u>
Tp. <u>W. J. C.</u>		<u>2514</u>		
H. <u>W. J. C.</u>		<u>2540</u>		<u>150' S & W</u>
Tr. <u>W. J. C.</u>		<u>2575</u>		<u>of C</u>
Dg.				
Bl.				
L.				Geol. _____
K.C.				Contr. _____
B.K.C.				Fees _____
Ce.				
C.				Pool _____
M.				<u>Hugoton</u>
M.				
K.				
Mz.				
Me.				
V.				
S.				
S.				
A.				
R.				
Pe.				
G.				
TD.	<u>2588</u>			

Sec.

COMPLETE
 JUN 26 57

No.

Date Comm. 5-19-57

Sec.

8" @ 288/200 WUC 4.1 57
5 1/2 2580 / 2 3/4 11.5 100 2588
11 " 55G DR 2598 FRAC
4x2 ga 158 MCH PA 2523
24/2497-2503 24/2530-36
40/2540-50 FRAC 6x3 ga
4 M. U. C. F. L. 72-20 ga
6,352 MCFEPPD

T.

R.