

KANSAS

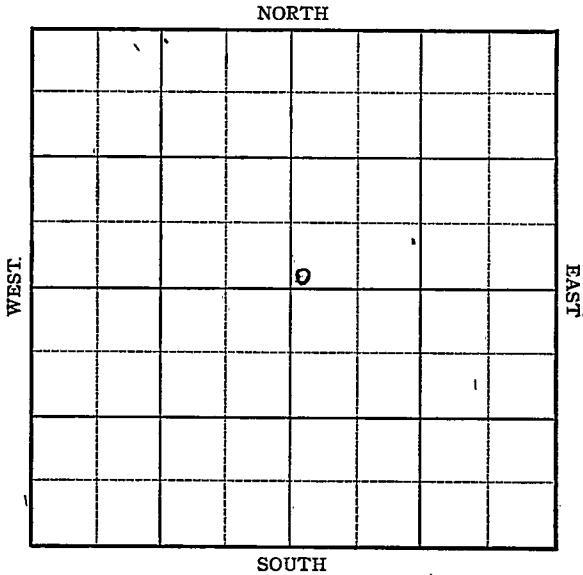
FORM 51 5M 11-44 PETROL

Kearny

Section 36 Township 21 Range 37W

Well No. 1 Meeker

Company Stanolind

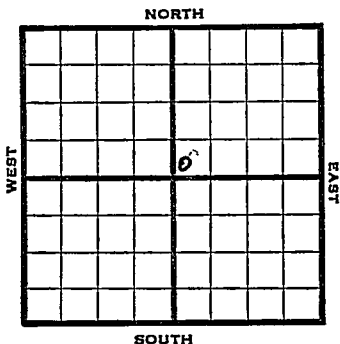


KANSAS

Kearny County

Sec. 36 Twp. 21 R. 37WWell No. #1 Meeker FarmStanolind Company

Hugoton

 Ft. from N. Line50 Ft. from S. Line Ft. from E. Line50 Ft. from W. Line

SW NE

1946

Elev. 3279

REPORT

5/29 Location

6/5 "

6/12 "

6/18 Surface hole

6/26 8" @ 996

Drlg 2215'

7/3 TD 2885-6" @ 2882 RUST

7/9 " " "

7/16 " " "

7/23 " " "

7/30 " " "

8/6 330 shots 2684 to 2862
1000 acid

8/14 6" @ 2882

TD 2885'

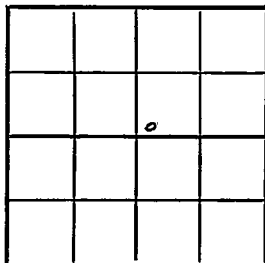
ABANDONED

Kansas Pool Name Hugoton~~KANSAS~~
Map No. Sec. 36 Twp. 21 R. 37WWell No. 1 MeekerStanolind Company

FIRST REPORT

SW NE Contractor

SECTION PLAT

 Ft. from N. Line50 Ft. from S. Line Ft. from E. Line50 Ft. from W. LineKearny CountyLocation XRig up

Drilling and Remarks:

RECORD

Cased in., ft.Sand Gas Oil Total Depth

PRODUCTION

1st 24 hrs. Nat. 1st 24 hrs. after shot Gas Cu. Ft.Dry Hole Abandoned

Date

MAY 20 1946 19 S. J. LEWIS Scout

KANSAS ~~Kansas~~ Pool Name Hugoton PoolMap No. _____ Sec. 36 Twp. 21 R. 37WWell No. 1 MeekerStanolind Company**ABANDONED**

Contractor

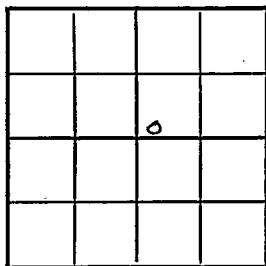
SW NE

E 13299
SECTION PLAT

_____ Ft. from N. Line

50 _____ Ft. from S. Line

_____ Ft. from E. Line

50 _____ Ft. from W. LineKearny County

Location _____

Rig up _____

Drilling and Remarks:

6" C 2882**RECORD**

Cased _____ in., _____ ft.

Sand _____

Gas _____

Oil _____

Total Depth 2885**PRODUCTION**

1st 24 hrs. Nat. _____

1st 24 hrs. after shot _____

Gas _____ Cu. Ft.

Dry Hole _____

Abandoned _____

Date

AUG 14 1946 19.S. J. LEWIS Scout