

Stafford


KANSAS

SECTION 4 TOWNSHIP 21S RANGE 13W

WELL NO. #3 Fanshier "A"

COMPANY Petroleum Inc.

NORTH N/2 NW NE

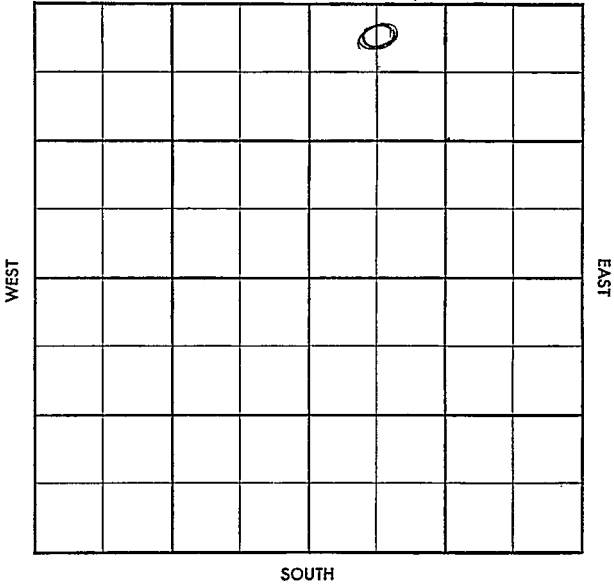

CO. Stafford ELEV. 18870

SEC. 4 TWP. 21 RGE. 13

COMPANY Petroleum Inc. NO. 3

| | | | | | |
|--|--|--|--|--|--|
| | | | | | |
| | | | | | |
| | | | | | |
| | | | | | |
| | | | | | |
| | | | | | |

FARM. Manshier "A"

LOC. N/2 E. 1/4

| |
|---------|
| A 760 |
| H 3154 |
| TR 3172 |
| Dg 3192 |
| B1 3270 |
| L 3284 |
| C 3517 |
| A 3585 |
| TD 3591 |

GEOL. _____
 CONTR. _____ 15#
 POOL Shaeffer
 SPUD 12-22-57
 Location DEC 26 57
 8" 280/230 ϕ 930
 2" 2" 52 DST 3400-18
 60" 1500' gip
 135' 140 gcm
 FP 160-180 BHP

500/30" DST 3485-3550 60"
 150' gcm 3pk oil FP 25-140

BHP 1025/30" ϕ 3578
 JAN 8 '58 5" 3587/100 woc

JAN 1 '58 JAN 22 '58 CO 3576 12/3528-31
 16/ 3518-22 16/3504-08 TST &

1/2 g FPH scum oil (1/2) Lost Ld.
 Erac 16x5 \$ 1.05 BFPH

2090w 20hrs PB 3440
 16/3410-16 2500 A \$

20.3 B FPH 10hrs 2090w
 1150' OB T&R JAN '58 FEB '58

FEB 12 '58 FEB 19 '58 FEB '58 P 7000 pd
 + 280 w

Lsg

CO
 USE
 NO.
 SEC.
 TWP.
 RGE.