


Stafford

KANSAS

SECTION 4 TOWNSHIP 21S RANGE 13W

WELL NO. #2 Fanshier "A"

COMPANY Petroleum Inc.

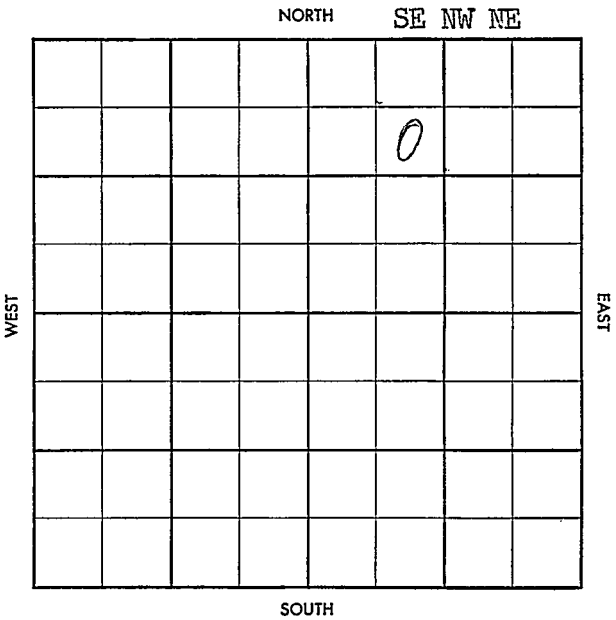

13

S-513-A

CO. Stafford ELEV. _____
SEC. 14 TWP. 21 RGE. 13W
COMPANY Petroleum Inc. NO. 2

NOV 13 1957		

FARM Fanshier "A"
LOC. SE NW NE

Anh. 752	

GEOL. _____
CONTR. Garvey
POOL Schaeffer
SPUD 10-10-57
8" @ 255/225 drlg.
1330

13

CO. _____
LSE. _____
NO. _____
SEC. _____
TWP. _____
RGE. _____

13

S-513-A

CO. Stafford ELEV. 1887
SEC. 1 TWP. 21 RGE. 13W
COMPANY Petroleum Inc NO. 2

COMPLETE
DEC 11 1957

FARM Fanshier "A"
LOC. SE N^W NE

Ant.	752

GEOL. _____
CONTR. Garvey
POOL Schaeffer
SPUD 10-10-57
8" @ 255/225 drls.
1330 NOV 29 57 Hb
3153 TR 3170
Dg 3187 BL 3269
Lsg 3279 DST
3400-18 60"

9/35" TSTM 240' GCO 265'
Loggy oil FP 200-340 BHP
620/20" DST 3423-74 60"
50' M FPO - 0 BHP 225/20"
C 3510 DST 3498-3542 60"
120' M FPO BHP 220/20"
3527 59. Oil 3567 DST 3498
3576. 60" 105' M SPK oil
BHP 300/20" RTD 3620 4"
3618/75. WOC 4 23

20 3606 1/2 24/3508-14
2 1/2 MW SCUM 0 PH 3 HUS
(3) AUTO XS 5 7B fld 4 11 90 W
2 HUS DEC 11 57 frac test 8 BDP A
20 90 W 16/ 3408-12 PB 3433
25 DDA 17 B F PH 5 90 W
T & R
25 BDP + 5 90 W

Lsg

CO.
LSE.
NO.
SEC.
TWP.
RGE.