

KANSAS

Form 51-5M-7-40-Palace

Stafford

Section 4 Township 21 Range 13-W

Well No. #1 Willcutt


Company Bodine Drilling

Wildcat

NORTH

WEST

EAST

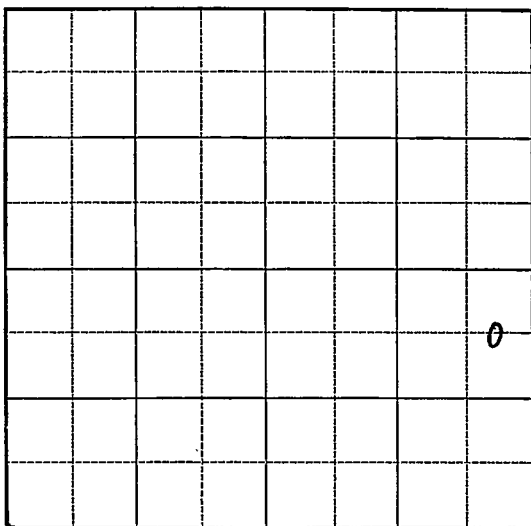

SOUTH

1941

4/23

Lans. 3270'

5" - 3467'

Arb. 3550'

T.D. 3560'

P.B. to K.C. 3467'

71 shots 3395-3405'

4000 acid.

Depthograph potential 2036 bbls.

30. Gravity

COMPLETED

Map No. 42 Sec. 4 Twp. 21 R. 13WWell No. 1 WillcuttBodine Drilling Company

Contractor

FIRST REPORT

C E L N E S E

660 Ft. from N. Line Ft. from S. Line330 Ft. from E. Line Ft. from W. Line

WILDCAT

SECTION PLAT

Location XRig up

Drilling and Remarks:

RECORDCased in., ft.Sand Gas Oil Total Depth **PRODUCTION**1st 24 hrs. Nat. 1st 24 hrs. after shot Gas Cu. Ft.Dry Hole Abandoned

Date

MAR 12 1941

19

S. I. LEWIS Scout

Misc. Sizing	RAY
Cards	RAY
Tracing	RAY
France Map	RAY
Scarlet Light	RAY
Moody	RAY
Cerlograd Dept.	RAY
McCarthy Cork	RAY

Map No. 82 Sec. 4 Twp. 21 R. 13WWell No. 1 WillicutBodine Drilling

Company

COMPLETED

Contractor

SECTION PLAT

C E L N E S E

660 Ft. from N. Line Ft. from S. Line330 Ft. from E. Line Ft. from W. Line

SHAEFFER POOL

Location Rig up

Drilling and Remarks:

Lane 32705" @ 3467228. 3550.P.D. to KC. 346271 Bkt to 3395-34054000 acidDepth 228 203630° Sr.

RECORD

Cased in., ft.Sand Gas Oil Total Depth 3560

PRODUCTION

1st 24 hrs. Nat. 1st 24 hrs. after shot Gas Cu. Ft.Dry Hole Abandoned

Date

APR 23 1941

19

S. J. LEWIS Scout

Misc. Small Maps	<i>DAW</i>
Cards	<i>DAW</i>
Tracing	<i>DAW</i>
France Map	<i>DAW</i>
Scrub Bush Map	<i>DAW</i>
Moody Map	<i>DAW</i>
Cenical Dept.	
Moody Flat Book	