


Section 4 Township 21 Range 13W

Well No. #1 Tucker "B"

Company Petroleum Inc.

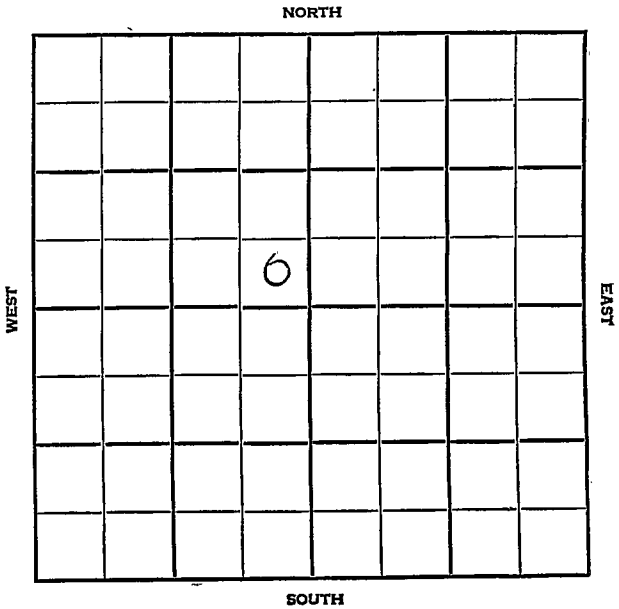

Stafford

KANSAS

SEC.	TWP.	R.
4	21	23 W

WELL NO. # 1 Tucker "B" FARM

COMPANY Petroleum Inc.

CONTRACTOR Garvey


_____ Ft. from N. Line

330 _____ Ft. from S. Line

330 _____ Ft. from E. Line

_____ Ft. from W. Line

SE SE NW

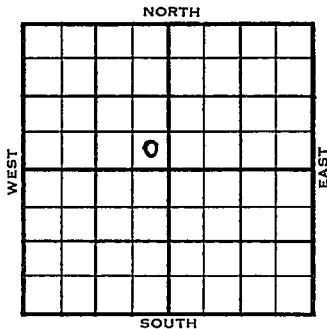

1955	ELEVATION	REPORT
------	-----------	--------

3/23	MIR	
------	-----	--

